

MISSISSIPPI
 BOARD OF WATER COMMISSIONERS
 416 North State Street
 Jackson, Mississippi 39201

CODED

SHARKEY
J25
6-17-71

WATER WELL DRILLERS LOG

DYER WELL & IRRIGATION SERVICE *S. SHARKEY*

6/17/71 19__
 date well completed

firm name

county well located

LANDOWNER:

MOORE PT. Co.

description of formations encountered

CLAY

from

to

0

28

SAND & CLAY

28

36

SAND

36

40

SAND & GRAVEL

40

103

CARY, MISS

(mailing address)

WELL LOCATION:

sec. *12* T. *10* N. R. *7* E. W. *W*
4 1/2 miles *S.E.* of *BLANTON*
 (distance) (direction) (nearest town)

WELL PURPOSE:

FISH
 (home, irrigation, municipal, industrial)

WELL COMPLETION DATA:

- (1) diameter (inches) *12*
- (2) total depth (feet) *103'*
- (3) static water level (feet) *24'* below above top of ground.
- (4) casing *Buc. Ir. 63'*
 (material) (depth)
- 12"*
 (size) if telescope see back.
- (5) screen *40' 63'*
 (length) (depth to top)
- 12" BUC. INGOT*
 (size) (material)
- (6) pump *30 1800*
 (HP) (yield gpm)
- ELEC.*
 (type power)
- (7) electric log *No*
 (yes or no)

CODED

(organization running log)

- (8) how well bottom plugged *PLATE*


OCT 26 1971

DRILLERS REMARKS:

MISS. RD. OR
 WATER COMM.

If well telescopes please sketch and show depths.

GROUND LEVEL

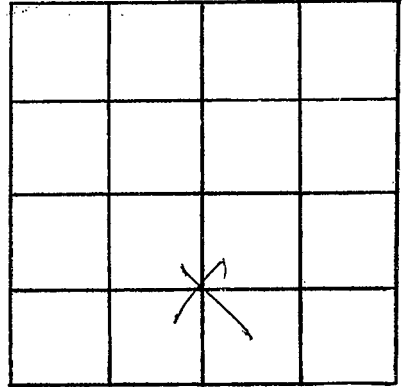

SECTION 12

Please indicate well location X.

ADDITIONAL INFORMATION

If more than one screen,
show locations of each on sketch.