

SHARKEY
J26
6-27-71

MISSISSIPPI
BOARD OF WATER COMMISSIONERS
416 North State Street
Jackson, Mississippi 39201

CODED

Sharkey

WATER WELL DRILLERS LOG

DYER WELL & IRRIGATION SERVICE

6/27/71 19
date well completed

firm name

county well located

LANDOWNER:

MOORE PLT. CO

CARY, MISS.
(mailing address)

WELL LOCATION:

sec. 12 T. 10 N. R. 7 E. S. 4
4 miles SE. of BLANTON
(distance) (direction) (nearest town)

WELL PURPOSE: RISE
(home, irrigation, municipal, industrial)

WELL COMPLETION DATA:

- (1) diameter (inches) 12"
- (2) total depth (feet) 110'
- (3) static water level (feet) 23' below above top of ground.
- (4) casing BUS. IR. 70'
(material) (depth)
12" if telescope see back.
(size)
- (5) screen 40' 70'
(length) (depth to top)
12" BUS. INGOT
(size) (material)
- (6) pump 30 1800
(HP) (yield gpm)
ELEC.
(type power)
- (7) electric log N/O
(yes or no)

(organization running log)

(8) how well bottom plugged PLATE

description of formations encountered

from

to

Gravel	0	22
WHITE CLAY	22	31
BLUE CLAY	31	45
SAND & CLAY	45	50
FINE SAND & GRAVEL	50	55
COARSE SAND & GRAVEL	55	60
SAND & GRAVEL	60	110

CODED


OCT 26 1971

DRILLERS REMARKS:

MISS. BD. OF
WATER COM. A.

If well telescopes please sketch and show depths.

GROUND LEVEL

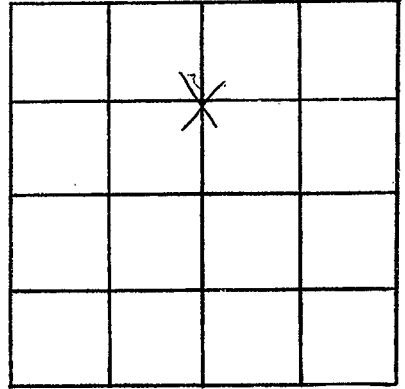

SECTION 12

Please indicate well location X.

ADDITIONAL INFORMATION

If more than one screen, show locations of each on sketch.