

SHARKEY
JZT
ELG # 74

MISSISSIPPI
 BOARD OF WATER COMMISSIONERS
 416 North State Street
 Jackson, Mississippi 39201

CODED

Sharkey C.
 before

WATER WELL DRILLERS LOG

May 2 1972 Delta Drilling Co. before
 date well completed firm name county well located

LANDOWNER: Dr. Wendell Johnson
Valley Park, Ms.
Bear-Kelso Plantation
 (mailing address)

WELL LOCATION: NW 1/4 - NW 1/4 -
 sec. 35 T. 10 N R. 7 W
Sharkey C.
 (distance) miles (direction) of (nearest town)

WELL PURPOSE:
 (home, irrigation, municipal, industrial)

WELL COMPLETION DATA:

- (1) diameter (inches) 4" x 2"
- (2) total depth (feet) 1526'
- (3) static water level (feet) _____ below
 top of ground. above
- (4) casing Steel pipe 1506
 (material) (depth)
- 4x2 If telescope see back.
 (size) 1506
- (5) screen 20' Stainless Steel
 (length) (depth to top)
- 2", Stainless Steel
 (size) (material)
- (6) pump 1 150
 (HP) (yield gpm)
- Electric
 (type power)
- (7) electric log yes
 (yes or no)
- U.S. Geological Survey
 (organization running log)
- (8) how well bottom plugged back pressure
valve

description of formations encountered	from	to
Gumbo	0	16
Sand	16	98
Gravel + Rock	98	176
Gumbo	176	424
Shale	424	738
Sand + Shale	738	846
Fine Sand + Shale	846	1090
Fine Sand	1090	1218
Gumbo, Shale + Rock	1218	1400
Hard Gumbo	1400	1411
Sand + 6" Rock	1411	1526

CODED

AUG - 7 1972


MADE IN OR
 REPRODUCED

DRILLERS REMARKS:

By Alfonso Wimmer

If well telescopes please sketch and show depths.

GROUND LEVEL

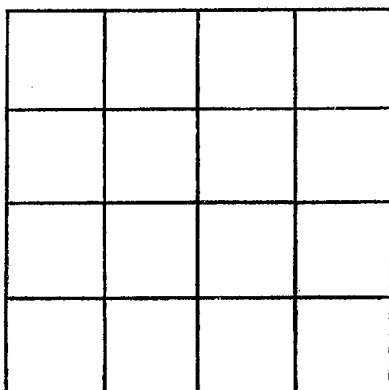

SECTION _____

Please indicate well location X.

ADDITIONAL INFORMATION

If more than one screen,
show locations of each on sketch.