

**JHARKEY**  
**J28**  
**Log # 75**

MISSISSIPPI  
 BOARD OF WATER COMMISSIONERS  
 416 North State Street  
 Jackson, Mississippi 39201

**CODED**

**WATER WELL DRILLERS LOG**

July 25 1973 F.M. "Bud" Cresswell Jharkey  
 date well completed firm name county well located

LANDOWNER:  
Ralph Farrell  
Osborne, Miss.  
 (mailing address)

description of formations encountered	from	to
<u>Clay</u>	<u>0</u>	<u>40</u>
<u>Sand - gravel</u>	<u>40</u>	<u>185</u>
<u>Sand</u>	<u>185</u>	<u>340</u>
<u>Blk shale</u>	<u>340</u>	<u>480</u>
<u>Sand</u>	<u>480</u>	<u>600</u>
<u>shales</u>	<u>600</u>	<u>830</u>
<u>Sand</u>	<u>830</u>	<u>908</u>
<u>Shale</u>	<u>908</u>	<u>955</u>

WELL LOCATION:  
 sec. 9 T. 10 N R. 7 E  
2 miles S of Blanton  
 (distance) (direction) (nearest town)

WELL PURPOSE: Farm  
 (home, irrigation, municipal, industrial)

WELL COMPLETION DATA:

(1) diameter (inches) 2

(2) total depth (feet) 955

(3) static water level (feet) 4 below top of ground.

(4) casing Steel, 880  
 (material) (depth)  
2 if telescope see back.  
 (size)

(5) screen 40, 880  
 (length) (depth to top)  
2, Stainless  
 (size) (material)

(6) pump 2, 35  
 (HP) (yield gpm)  
0  
 (type power)

(7) electric log yes  
 (yes or no)  
48 hrs  
 (organization running log)

(8) how well bottom plugged  
Steel plug


**CODED**

DRILLERS REMARKS:

**JUL 7 1973**

If well telescopes please sketch and show depths.

GROUND LEVEL

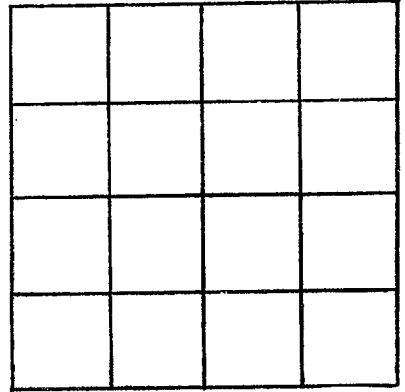

SECTION \_\_\_\_\_

Please indicate well location X.

ADDITIONAL INFORMATION

If more than one screen,  
show locations of each on sketch.