

SHARKEY
830
7-68

MISSISSIPPI
BOARD OF WATER COMMISSIONERS
416 North State Street
Jackson, Mississippi 39201

CODED

WATER WELL DRILLERS LOG

7-10 1968 Rollins Ford Maches & Sharkey
date well completed firm name county well located

LANDOWNER: Moore Planting Co
Cory, Miss
(mailing address)

description of formations encountered	from	to
<u>Loam</u>	<u>0</u>	<u>12</u>
<u>Blue Clay</u>	<u>12</u>	<u>32</u>
<u>Fine Sand</u>	<u>32</u>	<u>54</u>
<u>Coarse sand</u>	<u>54</u>	<u>77</u>
<u>Coarse sand + gravel</u>	<u>77</u>	<u>87</u>


WELL LOCATION:
sec 31 T. 10 N R. 7 E
4 miles SSW of Amvard
(distance) (direction) (nearest town)

WELL PURPOSE: Home
(home, irrigation, municipal, industrial)

WELL COMPLETION DATA:

- (1) diameter (inches) 2"
- (2) total depth (feet) 82'
- (3) static water level (feet) 14' below top of ground.
- (4) casing 4" dia, 84',
(material) (depth)
2" if telescope see back.
(size)
- (5) screen 3', 84'
(length) (depth to top)
2", Manil
(size) (material)
- (6) pump _____ (HP) _____ (yield gpm)
(type power)
- (7) electric log no (yes or no)
(organization running log)
- (8) how well bottom plugged check valve


CODED

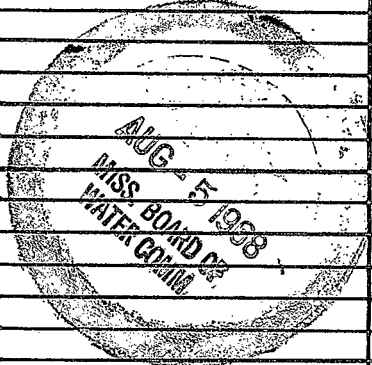

DRILLERS REMARKS:

If well telescopes please sketch and show depths.

GROUND LEVEL

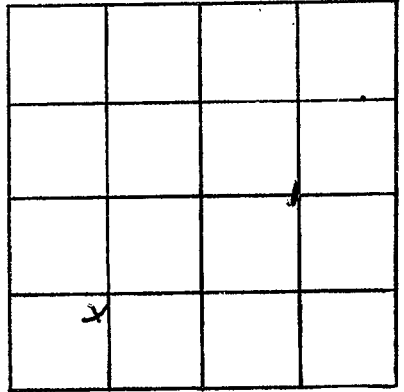

SECTION 31

Please indicate well location X.

ADDITIONAL INFORMATION

If more than one screen, show locations of each on sketch.