

SHARKEY
J33
11/8/78

MISSISSIPPI
BOARD OF WATER COMMISSIONERS
416 North State Street
Jackson, Mississippi 39201

CODED

WATER WELL DRILLERS LOG

11-8 1978 E.M. "Bud" Crosswell Sharkey
date well completed firm name county well located

LANDOWNER:	description of formations encountered	from	to
W.W. Moore Cary, MS. (mailing address)			
WELL LOCATION: sec 29 T 10 N R 7 E 4 miles NW of Valley Park (distance) (direction) (nearest town)			
WELL PURPOSE: Farm (home, irrigation, municipal, industrial)			
WELL COMPLETION DATA:			
(1) diameter (inches) 4			
(2) total depth (feet) 140			
(3) static water level (feet) 18 below top of ground.			
(4) casing PVC, 100 (material) (depth) 4 (size) If telescope see back.			
(5) screen 40, 100 (length) (depth to top) 4, PVC (size) (material)			
(6) pump 2, 100 (HP) (yield gpm) 0 (type power)			
(7) electric log No (yes or no)			
(organization running log)			
(8) how well bottom plugged Reef			
DRILLERS REMARKS:			

CODED


RECEIVED
ALL

DEC - 5 1978

MISS. BD. OF WATER COMMISSIONERS

If well telescopes please
sketch and show depths.

GROUND LEVEL

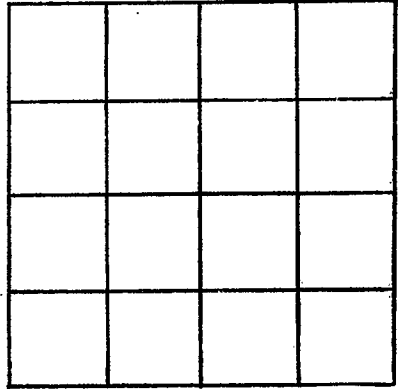

SECTION _____

Please indicate well location X.

ADDITIONAL INFORMATION

If more than one screen,
show locations of each on sketch.