

SHARKEY
 J 35
 4/21/78

MISSISSIPPI
 BOARD OF WATER COMMISSIONERS
 416 North State Street
 Jackson, Mississippi 39201

CODED

WATER WELL DRILLERS LOG

April 21, 1978 Dietz Well + Irrigation Sharkey
 date well completed firm name county well located

LANDOWNER: J.H. Moore	description of formations encountered	from	to
Carey, Miss. (mailing address)	Clay	0	13
	Clay	14	23
	Clay	24	33
	Clay	34	38
WELL LOCATION: sec. 14 T-10 N R-2 E 3 miles East of Osprey (distance) (direction) (nearest town)	FINE SAND	39	57
	SAND + GRAVEL	58	113
WELL PURPOSE: Irrigation - Rice (home, irrigation, municipal, industrial)	Bottom 113/ CODED		
WELL COMPLETION DATA:			
(1) diameter (inches) 16"			
(2) total depth (feet) 113'			
(3) static water level (feet) 18' below top of ground.			
(4) casing Steel 73' (material) (depth) 16" (size) if telescope see back.			
(5) screen 40' 73' (length) (depth to top) 16" Steel (size) (material)			
(6) pump 60 3,000 (HP) (yield gpm) DIESEL (type power)			
(7) electric log No (yes or no)			
(organization running log)			
(8) how well bottom plugged Plate			
DRILLERS REMARKS:			


Miss. Board of Water Comm.

FEB 6 1979

RECEIVED

If well telescopes please sketch and show depths.

GROUND LEVEL

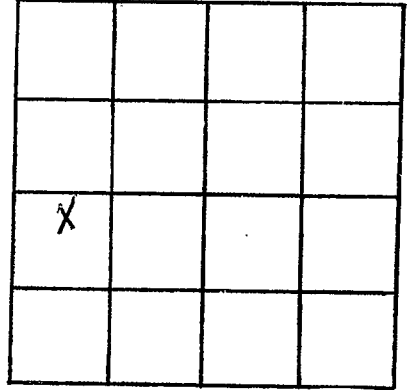

SECTION 14

Please indicate well location X.

ADDITIONAL INFORMATION

Lined area for additional information.

If more than one screen, show locations of each on sketch.