

SHARKEY
J37
8/18/78

MISSISSIPPI
BOARD OF WATER COMMISSIONERS
416 North State Street
Jackson, Mississippi 39201

WATER WELL DRILLERS LOG


CODED

Aug 18 1978 Dier Well & Irrigation Sharkey
date well completed firm name county well located

LANDOWNER: J.A. MOORE M. Co.	description of formations encountered	from	to
Carey, Miss. (mailing address)	Clay FINE SAND SAND & GRAVEL	0 36 60	35 59 103
<p>WELL LOCATION:</p> <p>sec. 2 T. 10 N R. 7 E S W</p> <p>4 miles SE of Carey (distance) (direction) (nearest town)</p>	Bottom 103'		
<p>WELL PURPOSE: Irrigation (home, irrigation, municipal, industrial)</p>	CODED		
<p>WELL COMPLETION DATA:</p> <p>(1) diameter (inches) 16"</p> <p>(2) total depth (feet) 103'</p> <p>(3) static water level (feet) 18' below above top of ground.</p> <p>(4) casing STEEL, 63' (material) (depth) 16" If telescope see back. (size)</p> <p>(5) screen 40', 63' (length) (depth to top) 16", STEEL (size) (material)</p> <p>(6) pump 60 3000 (HP) (yield gpm) Diesel (type power)</p> <p>(7) electric log No (yes or no)</p> <p>(organization running log)</p> <p>(8) how well bottom plugged Plate</p>			
<p>DRILLERS REMARKS:</p>	Miss. Board of Water Comm.	FEB 8 1979	RECEIVED

If well telescopes please sketch and show depths.

GROUND LEVEL

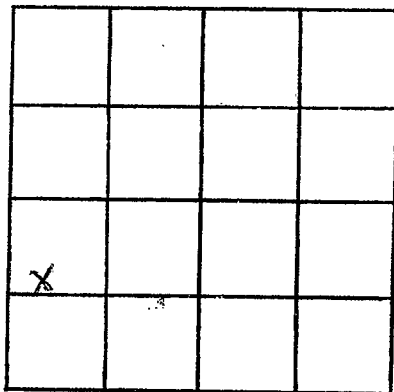

SECTION 2

Please indicate well location X.

ADDITIONAL INFORMATION

If more than one screen,
show locations of each on sketch.