

SHARKEY  
 J38  
 8/18/78

MISSISSIPPI  
 BOARD OF WATER COMMISSIONERS  
 416 North State Street  
 Jackson, Mississippi 39201

CODED

WATER WELL DRILLERS LOG

Aug-18-1978 date well completed  
 1978 Dyer Well + Irrigation firm name  
 Sharkey county well located

LANDOWNER: J.H. Moore, Jr. Co.  
 Carey, Miss. 39054 (mailing address)  
 WELL LOCATION:  
 sec. 2 T. 10 N. R. 7 E  
 4 miles SE of Carey (distance) (direction) (nearest town)

description of formations encountered	from	to
Clay	0	35
FINE SAND	36	59
SAND + GRAVEL	60	103
Bottom 103/		

WELL PURPOSE: Irrigation (home, irrigation, municipal, industrial)

WELL COMPLETION DATA:

(1) diameter (inches) 16"

(2) total depth (feet) 103'

(3) static water level (feet) 18' below top of ground.

(4) casing Steel, 63' (material) (depth)  
 16" (size) if telescope seo back.

(5) screen 40', 63' (length) (depth to top)  
 16" (size) Steel (material)

(6) pump 600 (HP) 3000 (yield gpm)  
 Diesel (type power)

(7) electric log No (yes or no)

(organization running log)

(8) how well bottom plugged Plate

CODED

Miss. Board of Water Comm.


FEB 6 1979

DRILLERS REMARKS:

RECEIVED

If well telescopes please sketch and show depths.

GROUND LEVEL

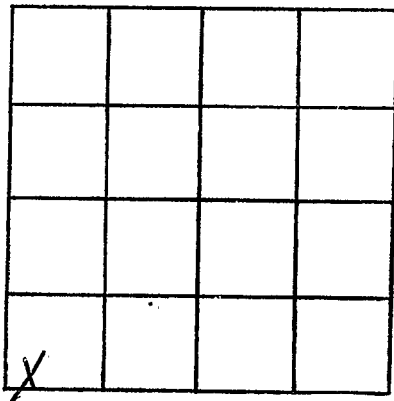

SECTION 2

Please indicate well location X.

ADDITIONAL INFORMATION

If more than one screen, show locations of each on sketch.