

SHARKEY
J 39
6/22/79

MISSISSIPPI
BOARD OF WATER COMMISSIONERS
416 North State Street
Jackson, Mississippi 39201

CODED

WATER WELL DRILLERS LOG

June 22 1979 Dreiling & Associates Sharkey

date well completed 1979 firm name county well located


LANDOWNER: Tom Wansley	description of formations encountered	from	to
Route 2			
Rolling Fork, MS 39159	Gray Clay	5	10
(mailing address)	Gray Clay	10	15
WELL LOCATION:	Gray Clay	15	20
sec. 17 10	Gray Clay	20	25
sec. T 10 (N) S 7 (W) R E	Gray Clay	25	30
14 miles NE of Valley Park	Blue Clay	30	35
(distance) (direction) (nearest town)	Blue Clay	35	40
WELL PURPOSE: Irrigation	Blue Clay	40	45
(home, irrigation, municipal, industrial)	Blue Clay	45	50
WELL COMPLETION DATA:	Brown Sand	50	55
(1) diameter (inches) 28"	Brown Sand	55	60
(2) total depth (feet) 136'	Sand & Gravel	60	65
(3) static water level (feet) 10	Sand & Gravel	65	70
below top of ground.	Gravel & Boulders	70	75
(4) casing Steel 16" 136'	Gravel & Boulders	75	80
(material) (depth)	Gravel	80	85
(size) if telescope see back.	Gravel	85	90
(5) screen 40' 96'	Gravel	90	95
(length) (depth to top)	Gravel & Boulders	95	100
16 Steel	Gravel & Boulders	100	105
(size) (material)	Gravel & Boulders	105	110
(6) pump 60 3500	Gravel & Boulders	110	115
(HP) (yield gpm)	Gravel & Boulders	115	120
Ford	Gravel & Boulders	120	125
(type power)	Gravel & Boulders	125	130
(7) electric log No	Gravel & Boulders	130	135
(yes or no)	Blue Clay	135	136
(organization running log)			
(8) how well bottom plugged Clay			
DRILLERS REMARKS:			

Miss. Board of Water Comm.
JUL 12 1979

RECEIVED


If well telescopes please sketch and show depths.

GROUND LEVEL

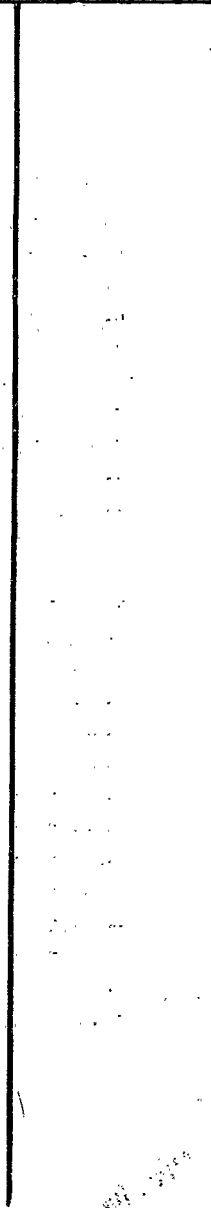

If more than one screen, show locations of each on sketch.

N

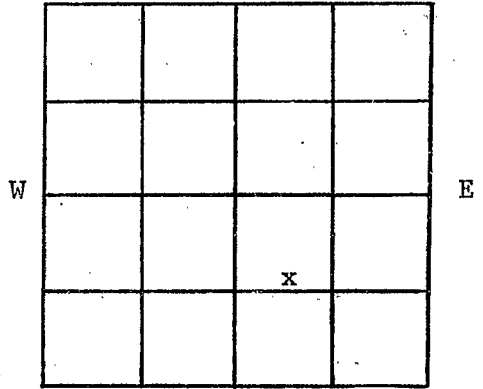

S

SECTION 17

Please indicate well location X.

ADDITIONAL INFORMATION

