

SHARKEY
T-40
6-29-79

MISSISSIPPI
BOARD OF WATER COMMISSIONERS
416 North State Street
Jackson, Mississippi 39201

CODED

WATER WELL DRILLERS LOG

SHARKEY
~~LEFFLORE~~

6/29
date well completed

1979 DYER WELL + IRR
firm name

county well located

LANDOWNER:	description of formations encountered	from	to
MOORE PLTG CO CAREY (mailing address)			
WELL LOCATION: sec. <u>1</u> T. <u>10</u> N. R. <u>7</u> E S W <u>5</u> miles <u>SE</u> of <u>CAREY</u> (distance) (direction) (nearest town)			
WELL PURPOSE: (home, irrigation, municipal, industrial)			
WELL COMPLETION DATA: (1) diameter (inches) <u>12</u> (2) total depth (feet) <u>113</u> (3) static water level (feet) <u>22</u> below top of ground. (4) casing <u>STEEL</u> <u>73</u> (material) (depth) <u>12</u> if telescope see back. (size) (5) screen <u>40</u> <u>73</u> (length) (depth to top) <u>12</u> <u>STEEL</u> (size) (material) (6) pump <u>40</u> <u>1500</u> (HP) (yield gpm) <u>DIESEL</u> (type power) (7) electric log <u>NO</u> (yes or no) (organization running log) (8) how well bottom plugged <u>PLATE</u>			
DRILLERS REMARKS:			


DEPT. OF NATURAL RESOURCES
BUREAU OF LAND & WATER RESOURCES

NOV 19 1979

RECEIVED

If well telescopes please sketch and show depths.

GROUND LEVEL

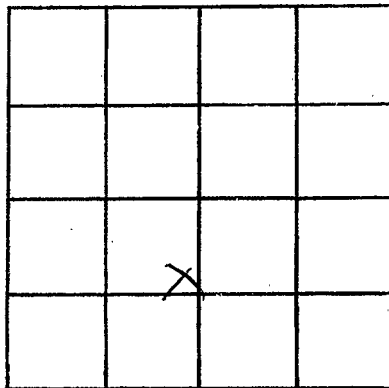

SECTION 1

Please indicate well location X.

ADDITIONAL INFORMATION

If more than one screen, show locations of each on sketch.