

**SHARKEY**  
**J-41**  
**01-29-80**

MISSISSIPPI  
 BOARD OF WATER COMMISSIONERS  
 416 North State Street  
 Jackson, Mississippi 39201

**CODED**

**WATER WELL DRILLERS LOG**

*Jan. 29* 19*80* *K.M. "Bud" Cresswell* *Sharkey*  
 date well completed firm name county well located

LANDOWNER:  
*W.W. Moore*  
*Cary, Mo.*  
 (mailing address)

description of formations encountered	from	to
<i>Clay sand gravel</i>	<i>0</i>	<i>45</i>
	<i>45</i>	<i>120</i>

WELL LOCATION:  
 sec *32* T *10* N R *7* E  
*5* miles *South* of *Blanton*  
 (distance) (direction) (nearest town)

WELL PURPOSE: *home*  
 (home, irrigation, municipal, industrial)

- WELL COMPLETION DATA:
- (1) diameter (inches) *4*
  - (2) total depth (feet) *120*
  - (3) static water level (feet) *10* below/above top of ground.
  - (4) casing *PVC*, *80*,  
 (material) (depth)  
*4* if telescope see back.  
 (size)
  - (5) screen *40*, *80*  
 (length) (depth to top)  
*4* *PVC*  
 (size) (material)
  - (6) pump *3* *75*  
 (HP) (yield gpm)  
 (type power)
  - (7) electric log *no*  
 (yes or no)
- (organization running log)

**CODED**

(8) how well bottom plugged:  
*has wash valve*

DRILLERS REMARKS:


DEPT. OF NATURAL RESOURCES  
 BUREAU OF LAND & WATER RESOURCES

FEB 25 1980

**RECEIVED**

If well telescopes please sketch and show depths.

GROUND LEVEL

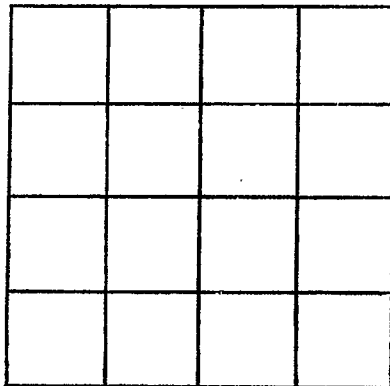

SECTION \_\_\_\_\_

Please indicate well location X.

ADDITIONAL INFORMATION

If more than one screen, show locations of each on sketch.