

MISSISSIPPI DEPARTMENT OF NATURAL RESOURCES

Bureau of Land and Water Resources

Southport Mall

P.O. Box 10631

Jackson, Mississippi 39209

WATER WELL DRILLERS LOG

CODED

| |
|---------|
| Sharkey |
| J 42 |
| 6-27-80 |

8/27 1980 DYER WELL & IRRE SHARKEY
 date well completed firm name county well located

| LANDOWNER: | description of formations encountered | from | to |
|--|---------------------------------------|------|-----|
| MOORE PLTG CO. | | | |
| CARY MISS 39054 (mailing address) | CLAY | 0 | 45 |
| | FINE SAND | 45 | 70 |
| | SAND | 70 | 85 |
| | SAND & GRAVEL | 85 | 123 |
| WELL LOCATION: sec. 3 T. 10 N. R. 7 E. S. (W) 4 1/2 miles S of CARY (distance) (direction) (nearest town) | | | |
| WELL PURPOSE: (home, irrigation, municipal, industrial) | | | |
| WELL COMPLETION DATA: | | | |
| (1) diameter (inches) 16 | | | |
| (2) total depth (feet) 123 | | | |
| (3) static water level (feet) 20 below above top of ground. | | | |
| (4) casing STEEL, 83 (material) (depth) | | | |
| 16 if telescope see back. (size) | | | |
| (5) screen 40 8.3 (length) (depth to top) | | | |
| 16 STEEL (size) (material) | | | |
| (6) pump 40 1800 (HP) (yield gpm) | | | |
| DIESEL (type power) | | | |
| (7) electric log NO (yes or no) | | | |
| (organization running log) | | | |
| (8) how well bottom plugged STEEL PLATE | | | |
| DRILLERS REMARKS: | | | |

CODED


DEPT. OF NATURAL RESOURCES
 BUREAU OF LAND & WATER RESOURCES

OCT - 1 1980

RECEIVED

If well telescopes please sketch and show depths.

GROUND LEVEL

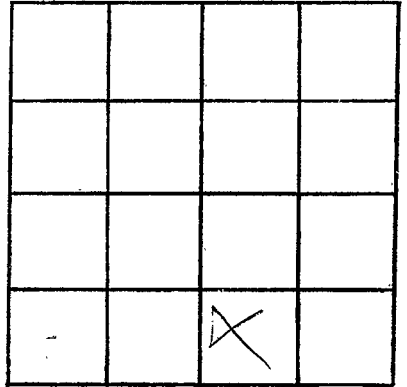

SECTION 3

Please indicate well location X.

ADDITIONAL INFORMATION

If more than one screen,
show locations of each on sketch.