

SHARKEY
J43
8-5-80

MISSISSIPPI
 BOARD OF WATER COMMISSIONERS
 416 North State Street
 Jackson, Mississippi 39201

CODED

WATER WELL DRILLERS LOG *Well #1*

8-5-80

Dreiling & Associates

Sharkey

date well completed

firm name

county well located

LANDOWNER: False River Farms

Tom Wansley

Route 2

Rolling Fork, Ms. 39159

(mailing address)

WELL LOCATION:

sec. 13 T. 10 (N) R. 7 (E)
 S (W)
6 miles North of Valley Park
 (distance) (direction) (nearest town)

WELL PURPOSE: irrigation
 (home, irrigation, municipal, industrial)

WELL COMPLETION DATA:

- (1) diameter (inches) 22"
- (2) total depth (feet) 114'
- (3) static water level (feet) 13 below top of ground. above
- (4) casing Steel 80'
 (material) (depth)
 (size) if telescope see back.
- (5) screen 40' 80'
 (length) (depth to top)
16" Steel
 (size) (material)
- (6) pump 60 3800
 (HP) (yield gpm)
 (type power)
- (7) electric log NO
 (yes or no)
 (organization running log)
- (8) how well bottom plugged Steel Plug

description of formations encountered

from

to

Top Soil	0	5
Clay	55	10
Clay	10	15
Clay	15	20
Clay	20	25
Fine Sand and Clay	25	30
Clay	30	35
Clay	35	40
Clay and Sand/Fine	40	45
Clay and Sand	45	50
Sand & Clay	50	55
Sand And Clay	55	60
Sand And Gravel	60	65
Sand & Gravel	65	70
Sand & Gravel	70	75
Sand & Gravel	75	80
Sand & Gravel	80	85
Sand & Gravel	85	90
Sand & Gravel	90	95
Sand & Gravel	95	100
Sand & Gravel	100	105
Sand & Gravel	105	110
Sand & Gravel	110	115

Bottom of Hole 114'

DEPT. OF NATURAL RESOURCES
 BUREAU OF LAND & WATER RESOURCES


SEP 30 1980

RECEIVED

DRILLERS REMARKS:

If well telescopes please sketch and show depths.

GROUND LEVEL

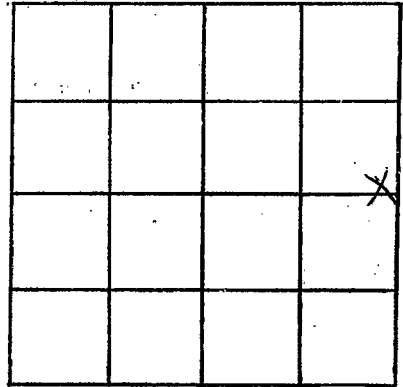

SECTION _____

Please indicate well location X.

ADDITIONAL INFORMATION

If more than one screen,
show locations of each on sketch.