

MISSISSIPPI DEPARTMENT OF NATURAL RESOURCES
Bureau of Land and Water Resources
 Southport Mall
 P.O. Box 10631
 Jackson, Mississippi 39209
WATER WELL DRILLERS LOG

CODED

Sharkey
J44
8-26-80

08/26 19 80 Larry's well & Pump Sharkey
 date well completed firm name county well located

LANDOWNER: Joe Carson
Rolling Fork miss
 (mailing address)

description of formations encountered	from	to
<u>clay</u>	<u>0</u>	<u>20</u>
<u>fine sand</u>	<u>20</u>	<u>50</u>
<u>med sand</u>	<u>50</u>	<u>114'</u>

WELL LOCATION:
 sec. 15 T X N R 7 E
3 miles SE of W Bland
 (distance) (direction) (nearest town)

CODED

WELL PURPOSE: Residential
 (home, irrigation, municipal, industrial)

- WELL COMPLETION DATA:
- diameter (inches) 16"
 - total depth (feet) 114'
 - static water level (feet) 16 below above top of ground.
 - casing Steel, 74'
 (material) (depth)
 (size) if telescope see back.
 - screen 40', 74'
 (length) (depth to top)
16", Steel
 (size) (material)
 - pump 1/2, 3000
 (HP) (yield gpm)
 (type power)
 - electric log NO
 (yes or no)
 (organization running log)
 - how well bottom plugged steel plate


DRILLERS REMARKS:

DEPT. OF NATURAL RESOURCES
 BUREAU OF LAND & WATER

MAY 18 1981
RECEIVED

If well telescopes please sketch and show depths.

GROUND LEVEL

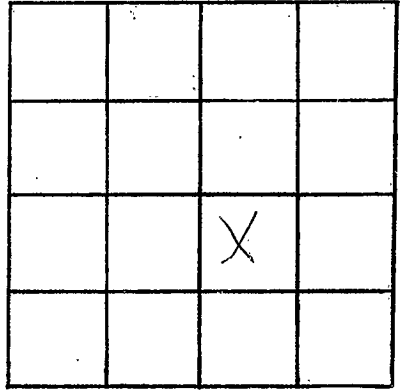

SECTION 15

Please indicate well location X.

ADDITIONAL INFORMATION

If more than one screen,
show locations of each on sketch.