

MISSISSIPPI DEPARTMENT OF NATURAL RESOURCES

Bureau of Land and Water Resources

Southport Mall

P.O. Box 10631

Jackson, Mississippi 39209

WATER WELL DRILLERS LOG

CODED

Sharkey  
J 45  
6-19-81

June 19 1981 Larry's well & Pump Sharkey  
 date well completed firm name county well located

13 LANDOWNER: W. Moore  
Cary, Miss  
 (mailing address)  
 WELL LOCATION:  
 sec. 15 T 10 N R 7 E  
6 miles SE of Blanton  
 (distance) (direction) (nearest town)

description of formations encountered	from	to
<u>Clay</u>	<u>0</u>	<u>30</u>
<u>fine sand</u>	<u>30</u>	<u>53</u>
<u>Mud to coarse sand</u>	<u>53</u>	<u>117</u>

WELL PURPOSE:  
 (home, irrigation, municipal, industrial)

WELL COMPLETION DATA:  
 (1) diameter (inches) 12"  
 (2) total depth (feet) 117  
 (3) static water level (feet) 15 below above top of ground.  
 (4) casing Steel, 77,  
 (material) (depth)  
 (size) if telescope see back.  
 (5) screen 40, 77  
 (length) (depth to top)  
12, steel  
 (size) (material)  
 (6) pump \_\_\_\_\_ (HP) \_\_\_\_\_ (yield gpm)  
 (type power)  
 (7) electric log no  
 (yes or no)  
 (organization running log)  
 (8) how well bottom plugged Steel Plate


CODED

DEPT. OF NATURAL RESOURCES  
 BUREAU OF LAND & WATER RESOURCES  
 JUL 16 1981  
 RECEIVED

DRILLERS REMARKS:

If well telescopes please sketch and show depths.

GROUND LEVEL

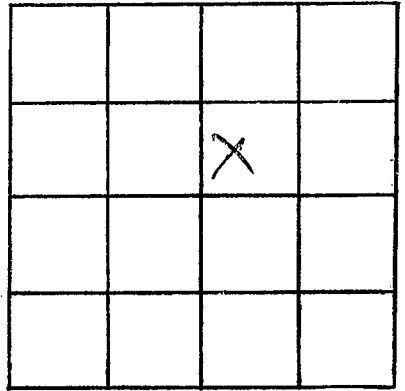

SECTION 15

Please indicate well location X.

ADDITIONAL INFORMATION

If more than one screen, show locations of each on sketch.