

MISSISSIPPI DEPARTMENT OF NATURAL RESOURCES

Bureau of Land and Water Resources

Southport Mall

P.O. Box 10631

Jackson, Mississippi 39209

WATER WELL DRILLERS LOG

J59
 SHARKEY CO.
 2-29-84

CODED

February 29, 1984 Irrigation Equip., Inc. Sharkey
 date well completed firm name county well located

LANDOWNER: Moore Planting Co.	Description of formations encountered	from	to
P.O. Box 209	Clay	0	45
Gary, Ms. 39054	Fine Sand	45	75
(mailing address)	Coarse Sand	75	115
WELL LOCATION:			
sec. 3 T 10 S R 7 E			
1 1/2 miles W of Blanton			
(distance) (direction) (nearest town)			
WELL PURPOSE: Industrial			
(home, irrigation, municipal, industrial)			
WELL COMPLETION DATA:			
(1) diameter (inches) 16"			
(2) total depth (feet) 115'			
(3) static water level (feet) 18 below top of ground.			
(4) casing Steel, 75'			
(material) (depth)			
(size) if telescope see back.			
(5) screen 40', 75'			
(length) (depth to top)			
16" Steel			
(size) (material)			
(6) pump 40, 2000			
(HP) (yield gpm)			
Electric			
(type power)			
(7) electric log No			
(yes or no)			
(organization running log)			
(8) how well bottom plugged Steel Plate			
DRILLERS REMARKS:			

CODED


DEPT. OF NATURAL RESOURCES
 BUREAU OF LAND & WATER RESOURCES

MAR 26 1984

RECEIVED

If well telescopes please sketch and show depths.

GROUND LEVEL

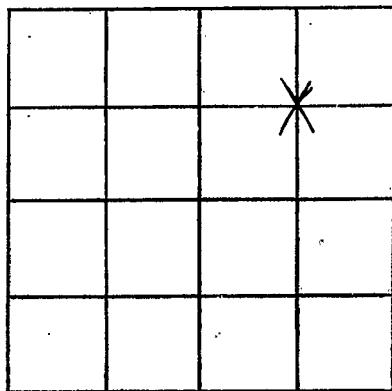

SECTION _____

Please indicate well location X.

ADDITIONAL INFORMATION

If more than one screen,
show locations of each on sketch.