

JLW  
 SHARKEY CO  
 2-30-84

MISSISSIPPI DEPARTMENT OF NATURAL RESOURCES  
 Bureau of Land and Water Resources  
 Southport Mall  
 P.O. Box 10631  
 Jackson, Mississippi 39209  
**WATER WELL DRILLERS LOG**

**CODED**

February 30, 1984 Irrigation Equip., Inc. Sharkey  
 date well completed firm name county well located

LANDOWNER: Moore Planting Co. P.O. Box 209 Cary, Ms. 39054 (mailing address)	description of formations encountered	from	to
	Clay	0	50
	Clay & Fine Sand	50	70
	Fine Sand	70	105
	Coarse Sand	105	130
<b>WELL LOCATION:</b>			
sec. 3 T10 S R. 7 W of Blanton (distance) (direction) (nearest town)			
<b>WELL PURPOSE:</b> Industrial (home, irrigation, municipal, industrial)			
<b>WELL COMPLETION DATA:</b>			
(1) diameter (inches) 16"			
(2) total depth (feet) 130'			
(3) static water level (feet) 18 below above top of ground.			
(4) casing Steel, 110' (material), (depth)			
_____ if telescope see back. (size)			
(5) screen 20' 110' (length), (depth to top)			
16" Steel (size), (material)			
(6) pump 40 2000 (HP), (yield gpm)			
Electric (type power)			
(7) electric log No (yes or no)			
_____ (organization running log)			
(8) how well bottom plugged Steel Plate			
DRILLERS REMARKS:			

**CODED**


DEPT. OF NATURAL RESOURCES  
 BUREAU OF LAND & WATER RESOURCES

MAR 26 1984

**RECEIVED**

If well telescopes please sketch and show depths.

GROUND LEVEL

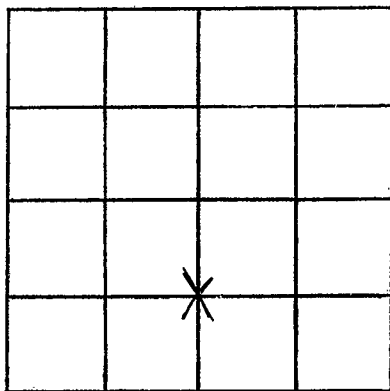

SECTION \_\_\_\_\_

Please indicate well location X.

ADDITIONAL INFORMATION

If more than one screen,  
show locations of each on sketch.