

MISSISSIPPI DEPARTMENT OF NATURAL RESOURCES

Bureau of Land and Water Resources

Southport Mall

P.O. Box 10631

Jackson, Mississippi 39209

WATER WELL DRILLERS LOG

J 62
Sharkey

4-3-85
date well completed

19 IRRIGATION Equipment
firm name

SHARKEY
county well located

LANDOWNER: MOORE PLANTING CO.
Hwy 61 South CARY, MS
(mailing address)

description of formations encountered	from	to
Clay	0	60
course sand	60	100
sand/pea gravel	100	120

WELL LOCATION:
sec. 19 T. 10 N. R. 7 E
10 miles South of CARY
(distance) (direction) (nearest town)

WELL PURPOSE: IRRIGATION
(home, irrigation, municipal, industrial)

- WELL COMPLETION DATA:
- (1) diameter (inches) 16"
 - (2) total depth (feet) 120
 - (3) static water level (feet) 6 below top of ground.
 - (4) casing steel, 80' (material) (depth)
 - (5) screen 40' 80' (length) (depth to top)
16" steel (size) (material)
 - (6) pump (HP) (yield gpm)
(type power)
 - (7) electric log (yes or no)
(organization running log)
 - (8) how well bottom plugged steel plate

DRILLERS REMARKS:

RECEIVED


MAY - 2 1985

Department of Natural Resources
Bureau of Land & Water Resources

If well telescopes please sketch and show depths.

IRRIGATION EQUIPMENT
601/887-2555
INDIANOLA, MS.

GROUND LEVEL

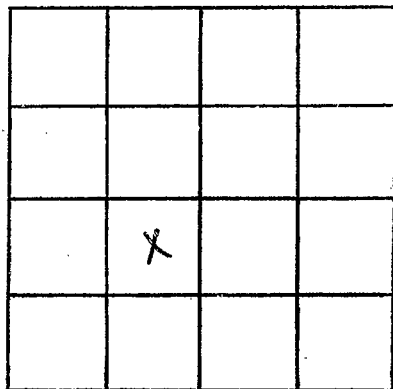

SECTION 19

Please indicate well location X.

ADDITIONAL INFORMATION

If more than one screen,
show locations of each on sketch.