

SHARKEY
 J 2000
 10-12-77

MISSISSIPPI
 BOARD OF WATER COMMISSIONERS
 416 North State Street
 155 Jackson, Mississippi 39201

WATER WELL DRILLERS LOG

Sharkey

10-12-77 date well completed 77 E.M. "Bud" Cresswell firm name Issaquena county well located

LANDOWNER:
Tom Wansley
Valley Park, Ms.
 (mailing address)

description of formations encountered	from	to
<i>clay</i>	<i>0</i>	<i>20</i>
<i>Red-gravel</i>	<i>20</i>	<i>170</i>
<i>blue clay</i>	<i>170</i>	<i>420</i>
<i>sandy shale</i>	<i>420</i>	<i>700</i>
<i>shale</i>	<i>700</i>	<i>800</i>
<i>band</i>	<i>800</i>	<i>900</i>

WELL LOCATION:
 sec 35 T 10 N R 7 E
3 miles *North* of *Valley Park*
 (distance) (direction) (nearest town)

WELL PURPOSE: *home*
 (home, irrigation, municipal, industrial)

- WELL COMPLETION DATA:
- (1) diameter (inches) 4
 - (2) total depth (feet) 900
 - (3) static water level (feet) 14 below top of ground.
 - (4) casing Steel 870
 (material) (depth)
 - 2 If telescope see back.
 (size)
 - (5) screen 30 870
 (length) (depth to top)
 - 2 STAINLESS
 (size) (material)
 - (6) pump 1 25
 (HP) (yield gpm)
 - 0
 (type power)
 - (7) electric log No
 (yes or no)
 - 0
 (organization running log)

(8) how well bottom plugged
Steel plug


DRILLERS REMARKS:

RECEIVED
 OCT 17 1977

MISS. BD. OF WATER COMMISSIONERS

If well telescopes please sketch and show depths.

GROUND LEVEL

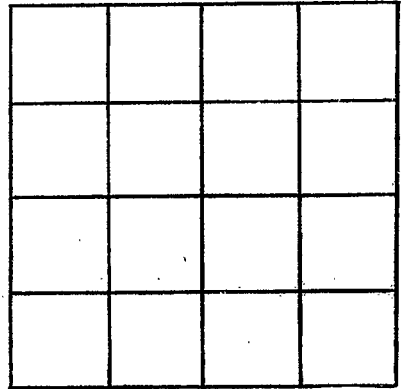

SECTION _____

Please indicate well location X.

ADDITIONAL INFORMATION

If more than one screen, show locations of each on sketch.