

MISSISSIPPI DEPARTMENT OF NATURAL RESOURCES

Bureau of Land and Water Resources

Southport Mall

P.O. Box 10631

Jackson, Mississippi 39209

WATER WELL DRILLERS LOG

J 2001
 Sharkey
 8-28-85

Aug. 28 1985 F.M. Bud Cresswell Sharkey
 date/well completed firm name county well located


LANDOWNER:
 Wesley Wilcox
 Valley Park, MS.
 (mailing address)

description of formations encountered	from	to
Clay	0	60
Sand-gravel	60	130

WELL LOCATION:
 sec. 34 T-10 N R-7 E
 2 miles North of Valley Park
 (distance) (direction) (nearest town)

WELL PURPOSE: Home
 (home, irrigation, municipal, industrial)

- WELL COMPLETION DATA:
- (1) diameter (inches) 2
 - (2) total depth (feet) 130
 - (3) static water level (feet) 16 below top of ground.
 - (4) casing PVC 120 (material) (depth)
 2 (size) if telescope see back.
 - (5) screen 10 120 (length) (depth to top)
 2 PVC (size) (material)
 - (6) pump none 20 (HP) (yield gpm)
 (type power)
 - (7) electric log No (yes or no)
 (organization running log)
 - (8) how well bottom plugged steel with valve

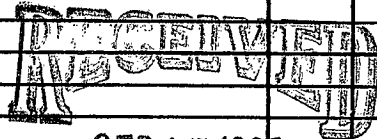


SEP 17 1985

DRILLERS REMARKS:

Department of Natural Resources
 Bureau of Land & Water Resources

If well telescopes please sketch and show depths.

GROUND LEVEL

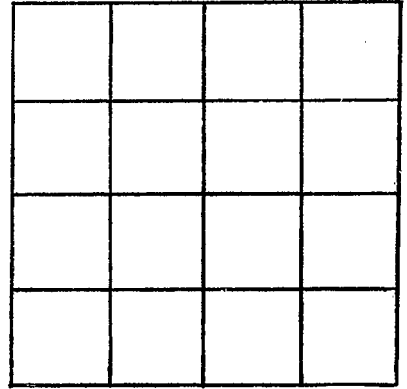

SECTION _____

Please indicate well location X.

ADDITIONAL INFORMATION

If more than one screen,
show locations of each on sketch.