

MISSISSIPPI DEPARTMENT OF NATURAL RESOURCES

Bureau of Land and Water Resources

Southport Mall

P.O. Box 10631

Jackson, Mississippi 39209

WATER WELL DRILLERS LOG

SHARKEY  
J 2002

12-18  
date well completed

81 E.M. Bud Cresswell  
firm name

Sharkey  
county well located

LANDOWNER:  
W.W. Moore  
Cary, MS.  
(mailing address)

description of formations encountered

from

to

Surface deposits	0	40
Sand - gravel	40	180
Sand sh. shale	180	345
Shale	345	480
Sand	480	600
Shale hard	600	830
Sand	830	845
shale	845	865
sand	865	900
shale	900	955

WELL LOCATION:  
sec 8 T 10 N R 7 W  
1 miles North of Onward  
(distance) (direction) (nearest town)

WELL PURPOSE: Home  
(home, irrigation, municipal, industrial)

WELL COMPLETION DATA:  
(1) diameter (inches) 4  
(2) total depth (feet) 900  
(3) static water level (feet) 25 below top of ground.  
(4) casing Steel, 860,  
(material) (depth)  
4 if telescope see back.  
(size)  
(5) screen 40, 860  
(length) (depth to top)  
2 SPAINLESS  
(size) (material)  
(6) pump 1 20  
(HP) (yield gpm)  
(type power)  
(7) electric log no  
(yes or no)  
(organization running log)

(8) how well bottom plugged  
Sand shale

DRILLERS REMARKS:  
Drilled to 955


RECEIVED

JAN 7 1993

Department of Natural Resources  
Bureau of Land & Water Resources

If well telescopes please  
sketch and show depths.

GROUND LEVEL

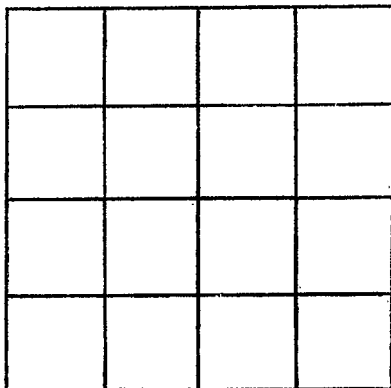

SECTION \_\_\_\_\_

Please indicate well location X.

ADDITIONAL INFORMATION

If more than one screen,  
show locations of each on sketch.