

ELOG# 73

MISSISSIPPI
BOARD OF WATER COMMISSIONERS
416 North State Street
Jackson, Mississippi 39201

CODED

WATER WELL DRILLERS LOG

SHARKEY
KS
12-13-71

Dec. 13 1971 E.M. "Bud" Cresswell SHARKEY
date well completed firm name county well located

LANDOWNER:
W.H. Coghlan
Holly Bluff, Miss.
(mailing address)

description of formations encountered	from	to
<u>CLAY</u>	<u>0</u>	<u>40</u>
<u>SAND-gravel</u>	<u>40</u>	<u>160</u>
<u>Clay</u>	<u>160</u>	<u>330</u>
<u>SAND</u>	<u>330</u>	<u>380</u>
<u>SAND</u>	<u>380</u>	<u>510</u>
<u>SHALE</u>	<u>510</u>	<u>640</u>
<u>SAND</u>	<u>640</u>	<u>660</u>

WELL LOCATION:
sec. 5 T10 N R 5 E
1 miles South of Spanish Fort
(distance) (direction) (nearest town)

WELL PURPOSE: Domestic
(home, irrigation, municipal, industrial)

- WELL COMPLETION DATA:
- (1) diameter (inches) 4 X 2
 - (2) total depth (feet) 660
 - (3) static water level (feet) 12 below top of ground.
 - (4) casing steel 640
(material) (depth)
 - 2 if telescope see back.
(size)
 - (5) screen 20 640
(length) (depth to top)
 - 2 STAINLESS
(size) (material)
 - (6) pump 3/4 20
(HP) (yield gpm)
 - 0
(type power)
 - (7) electric log yes
(yes or no)
 - STATE
(organization running log)
 - (8) how well bottom plugged
Steel plug

CODED


JAN 12 1972

MISS. BD. OF
WATER COM. L.

DRILLERS REMARKS:

If well telescopes please sketch and show depths.

GROUND LEVEL

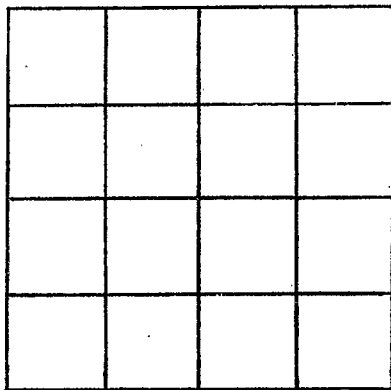

SECTION _____

Please indicate well location X.

ADDITIONAL INFORMATION

If more than one screen, show locations of each on sketch.