

A2

2-8-61

WATER WELL DRILLERS LOG

CONFID

Date: 2/8, 1961, Driller: Wayne Rebit County Simpson

(1) Owner of Land: W F Borlow (Name) 3 Laurel Pt 2 (Address)

(2) Location: 1/4, 1/4, Sec 3 T2R1, 10 miles NE of Laurel (distance), (direction), (Nearest Town)

(3) Topography: (Hilly) (Flat) (Level)

(4) Purpose of Well: (Domestic Irrigation Municipal, Industrial, Other)


Table with 3 columns: Description & Color of Materials (Sand, Clay, Red Clay, Shell, etc.), Thickness Feet, Depth Feet. Entries include red clay, bucket chalk, Blue Shell, Blue Sand.

Information upon completion of well:

- (1) Diameter 2 inches. (2) Total Depth 185 feet. (3) Water Level 40 feet below top of ground. (4) Cased to 175, Size 2". (5) Screen: Size 1/4, Length 10. (6) Were any formations sealed against pollution?

yes, no. If YES depth of formation Why

Drillers Remarks:

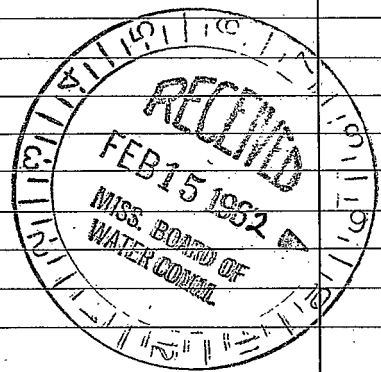

(Use Back Side)

Well No

