

A 3  
10-3-60

WATER WELL DRILLERS LOG <sup>300</sup>

Date: 10/3, 1960, Driller: James A. White County Simpson  
(Name)

- (1) Owner of Land: Willard J. Emms, Welch  
(Name)  
7 Laurel Rt 740  
(Address)
- (2) Location: NW 1/4, NE 1/4, Sec. 16 T2 R1E  
11 miles East of Serry  
(distance) (direction) (Nearest Town)
- (3) Topography:  (Hilly)  (Flat)  (Level)
- (4) Purpose of Well: Domestic  
(Domestic Irrigation, Municipal, Industrial, Other)

Description & Color of Materials Sand, Clay, Red Clay, Shell, etc.	Thick- ness Feet	Depth Feet
<u>Red Clay</u>	<u>15</u>	<u>15</u>
<u>Sand with shells</u>	<u>45</u>	<u>50</u>
<u>Shell</u>	<u>150</u>	<u>200</u>
<u>Sand</u>	<u>8</u>	<u>208</u>


Information upon completion of well:

- (1) Diameter 2 inches.
- (2) Total Depth 208 feet.
- (3) Water Level 78 feet below top of ground.
- (4) Cased to 168, Size 2"
- (5) Screen: Size open, Length \_\_\_\_\_
- (6) Were any formations sealed against pollution?  
\_\_\_\_\_ yes, \_\_\_\_\_ no.

If YES depth of formation \_\_\_\_\_  
Why \_\_\_\_\_

Drillers Remarks: \_\_\_\_\_  
\_\_\_\_\_  
\_\_\_\_\_

CODED

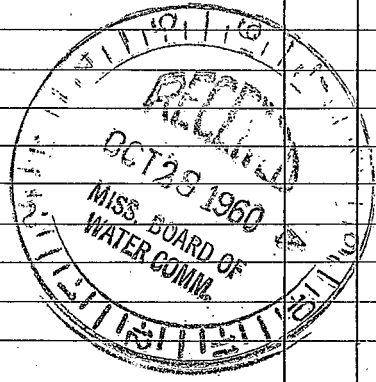

(Use Back Side)

Well No.

