

SIMPSON
5 A4
5-68

MISSISSIPPI
BOARD OF WATER COMMISSIONERS
416 North State Street
Jackson, Mississippi 39201

CODED

WATER WELL DRILLERS LOG

May 2, 1968 19 Thompson Well Service Simpson
date well completed firm name county well located

LANDOWNER: W. S. Ashley
R. I. Harrison
(mailing address)

WELL LOCATION:
35-9 sec 26 T 2 N R 1 E
6 miles W of Norrisville
(distance) (direction) (nearest town)

WELL PURPOSE: Home
(home, irrigation, municipal, industrial)

WELL COMPLETION DATA:

(1) diameter (inches) 2

(2) total depth (feet) 142

(3) static water level (feet) 75 below
top of ground.

(4) casing 2" Gal. 133'
(material) (depth)

2 If telescope see back.
(size)

(5) screen 6" 133'
(length) (depth to top)

2" Alumina
(size) (material)

(6) pump 3/4 3
(HP) (yield gpm)

Elec.
(type power)

(7) electric log no
(yes or no)

(organization running log)

(8) how well bottom plugged Rock Hard

description of formations encountered	from	to
hard clay	0	5
hard	5	15
Reddish & blue clay	15	55
hard grey sand	55	58
blue clay	58	59
hard	59	60
blue clay sandy	60	87
hard	87	88
blue clay	88	92
hard	92	93
rock	93	75
big 7' sand & gravel	95	98
rock	98	101
hard	101	140
blue clay	140	142


CODED

JUN 1 1968
MISS. BOARD OF
WATER COMMISSIONERS

DRILLERS REMARKS: Pump set
on the sand well will
blow 6 M G M with
air

If well telescopes please sketch and show depths.

GROUND LEVEL

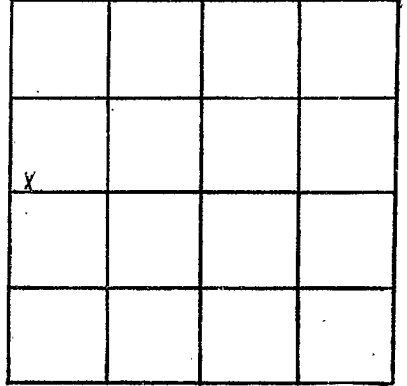

SECTION 36

Please indicate well location X.

ADDITIONAL INFORMATION

If more than one screen,
show locations of each on sketch.