

0001090

Simpson

B3

12/67

Elec 109

12-23

date well completed

MISSISSIPPI  
 BOARD OF WATER COMMISSIONERS  
 416 North State Street  
 Jackson, Mississippi 39201

CODED

WATER WELL DRILLERS LOG

1967 Layne-Central Co. Simpson  
 firm name county well located

LANDOWNER:

Harrisville Water Association

Harrisville, Miss

(mailing address)

WELL LOCATION:

on fully property

sec. 34 T 2 N R 2 E  
S W

(distance) miles (direction) of (nearest town)

WELL PURPOSE:

Domestic

(home, irrigation, municipal, industrial)

WELL COMPLETION DATA:

- (1) diameter (inches) 10"
- (2) total depth (feet) 321'
- (3) static water level (feet) 120' below above top of ground.
- (4) casing Steel, 276', (material) (depth)

(size) If telescope see back.

- (5) screen 40', 276' (length) (depth to top)

6", Stainless Steel (size) (material)

- (6) pump 2.5 (HP) (yield gpm)

Electric (type power)

- (7) electric log yes (yes or no)

Miss. Gen. Survey (organization running log)


- (8) how well bottom plugged Cement

description of formations encountered

from to

<u>Clay</u>	<u>0</u>	<u>30</u>
<u>with sandy clay with thin sh.</u>	<u>30</u>	<u>70</u>
<u>Rock</u>	<u>70</u>	<u>73</u>
<u>Shale with hard streaks</u>	<u>73</u>	<u>174</u>
<u>Shale with sand streaks</u>	<u>174</u>	<u>256</u>
<u>Sandy Shale</u>	<u>256</u>	<u>275</u>
<u>Sand</u>	<u>275</u>	<u>317</u>
<u>Hard Shale</u>	<u>317</u>	<u>361</u>
<u>Sand</u>	<u>361</u>	<u>384</u>
<u>Hard Shale</u>	<u>384</u>	<u>406</u>
<u>Clay</u>	<u>406</u>	<u>451</u>
<u>Hard Shale</u>	<u>451</u>	<u>496</u>
<u>Sandy Shale</u>	<u>496</u>	<u>560</u>
<u>Rocky Shale</u>	<u>560</u>	<u>566</u>

CODED

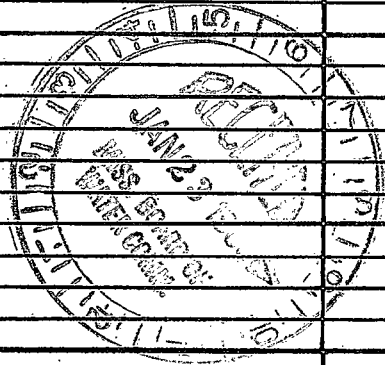

DRILLERS REMARKS:


Pump not installed as of this date - No Test run -

4

If well telescopes please sketch and show depths.

GROUND LEVEL

S/2 NW, NE

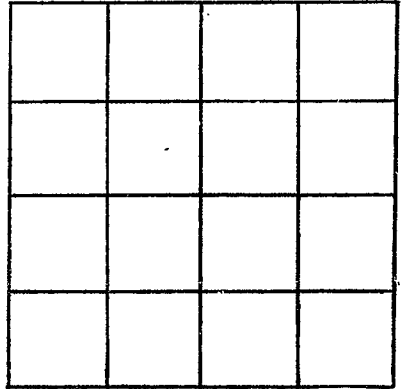

SECTION \_\_\_\_\_

Please indicate well location X.

ADDITIONAL INFORMATION

If more than one screen, show locations of each on sketch.