

SIMPSON MISSISSIPPI BOARD OF WATER COMMISSIONERS

B 5
8-6-60

WATER WELL DRILLERS LOG

B-304

Simpson
Smith

Date: 8/6, 1960, Driller: Jones A. White County Simpson

(Name)

(1) Owner of Land: Bruce Robbins
(Name)
3 Lorend RT 2
(Address)

(2) Location: SW 1/4 SW 1/4, Sec. 17 T2 R2 E

3 miles west of Horisville
(distance) (direction) (Nearest Town)

(3) Topography: X
(Hilly) (Flat) (Level)

(4) Purpose of Well:
(Domestic Irrigation
Municipal, Industrial, Other)

Description & Color of Materials
Sand, Clay, Red Clay, Shell, etc.

Thick-
ness
Feet

Depth
Feet

red clay 16 76
blue shell 134 150
sand 5 155

Information upon completion of well:

(1) Diameter 2 inches.

(2) Total Depth 155 feet.

(3) Water Level 60 feet below top of ground.

(4) Cased to 124, Size 2

(5) Screen: Size 2 inch, Length _____

(6) Were any formations sealed against pollution?


_____ yes, _____ no.

If YES depth of formation _____

Why _____

Drillers Remarks: _____

CODED

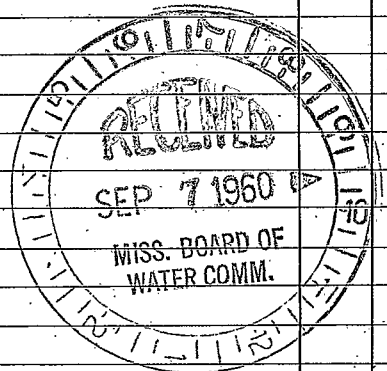

(Use Back Side)

Well No.

.....

.....

