

Simpson
B. H.
12-27-68

MISSISSIPPI
 BOARD OF WATER COMMISSIONERS
 416 North State Street
 Jackson, Mississippi 39201

CODED
 CODED

WATER WELL DRILLERS LOG

Dec. 27 1968 19 H. E. Thompson Simpson
 date well completed firm name county well located


LANDOWNER:	description of formations encountered	from	to
<u>Joe Weatherly</u> <u>Boonville Miss</u> (mailing address)			
WELL LOCATION: sec. <u>14</u> T. <u>2</u> N. R. <u>2</u> E <u>3 1/4</u> miles <u>N.</u> of <u>Madisonville</u> (distance) (direction) (nearest town)	<u>190'</u> <u>B. clay.</u>	<u>190</u>	<u>230</u>
WELL PURPOSE: <u>home</u> (home, irrigation, municipal, industrial)	<u>sand</u>	<u>230</u>	<u>240</u>
WELL COMPLETION DATA:	<u>Blue clay</u>	<u>240</u>	<u>260</u>
(1) diameter (inches) <u>2"</u>			
(2) total depth (feet) <u>260</u>			
(3) static water level (feet) <u>80</u> below above top of ground.			
(4) casing <u>Gal</u> , <u>147'</u> (material) (depth) <u>2"</u> if telescope see back. (size)			
(5) screen <u>open hole</u> (length) (depth to top) (size) (material)			
(6) pump _____ <u>12 Withair</u> (HP) (yield gpm) (type power)			
(7) electric log _____ (yes or no) (organization running log)			
(8) how well bottom plugged <u>open hole</u>			
DRILLERS REMARKS:			

CODED

FEB 13 1969
 MISS. DEPT. OF WATER CONTROL

If well telescopes please sketch and show depths.

GROUND LEVEL

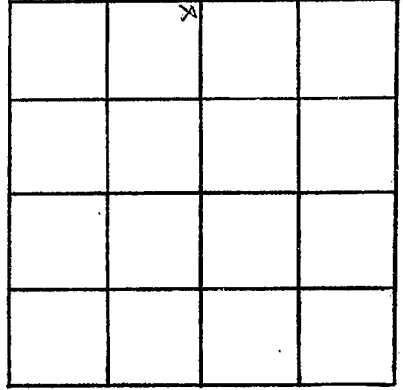

SECTION 14

Please indicate well location X.

ADDITIONAL INFORMATION

If more than one screen, show locations of each on sketch.