

Simpson
B-12
8/15/71

MISSISSIPPI **ELOG# 147**
BOARD OF WATER COMMISSIONERS
416 North State Street
Jackson, Mississippi 39201

CODED

WATER WELL DRILLERS LOG

8/15/71 19 W. P. Thompson Simpson
date well completed firm name county well located

LANDOWNER:
W. P. Byrd
Braxton Miss.
(mailing address)

WELL LOCATION:
sec 23 T 2 N R 2 E
5 1/2 miles W of Braxton
(distance) (direction) (nearest town)

WELL PURPOSE: HOME
(home, irrigation, municipal, industrial)

- WELL COMPLETION DATA:
- (1) diameter (inches) 2"
 - (2) total depth (feet) 253'
 - (3) static water level (feet) 70 below above top of ground.
 - (4) casing: Plastic, 140'
(material) (depth)
2"
(size) if telescope see back.
 - (5) screen open
(length) (depth to top)
(size) (material)
 - (6) pump 3/4 4.5
(HP) (yfeld gpm)
Int.
(type power)
 - (7) electric log yes
(yes or no)
M. B. S.
(organization running log)
 - (8) how well bottom plugged Open

| description of formations encountered | from | to |
|---------------------------------------|------------|------------|
| <u>TOP SOIL</u> | <u>0</u> | <u>6</u> |
| <u>WHITE CLAY</u> | <u>6</u> | <u>25</u> |
| <u>BLUE CLAY</u> | <u>25</u> | <u>70</u> |
| <u>SAND</u> | <u>71</u> | <u>75</u> |
| <u>BLUE CLAY</u> | <u>76</u> | <u>180</u> |
| <u>BLUE CLAY</u> | <u>180</u> | <u>210</u> |
| <u>SAND</u> | <u>210</u> | <u>253</u> |

CODED


AUG 27 1971

MISS. BD. OF
WATER COMM.

DRILLERS REMARKS:
Anting well @ 206-216

If well telescopes please sketch and show depths.

GROUND LEVEL

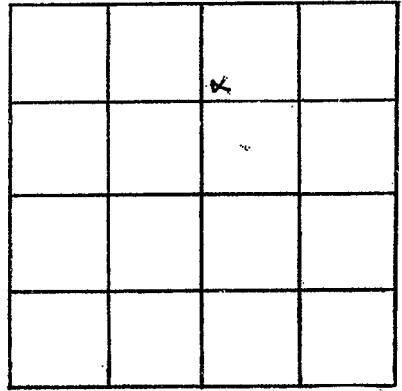

SECTION 23

Please indicate well location X.

ADDITIONAL INFORMATION

If more than one screen,
show locations of each on sketch.