

~~Will cancel log~~

Corrected to depth  
7 well 704 Sept  
24-76-JK

SIMPSON  
B21  
5-17-75  
Ewg#174

MISSISSIPPI  
BOARD OF WATER COMMISSIONERS  
416 North State Street  
Jackson, Mississippi 39201

WATER WELL DRILLERS LOG **CODED**

5-17 1975 Oriver-Cowan SIMPSON  
date well completed firm name county well located

LANDOWNER:  
Charles Croker  
JACKSON, Miss  
(mailing address)

description of formations encountered	from	to
Top Soil	0	1
Clay	1	60
Rock	60	62
Clay + Chalk	62	180
Chalk + Rock	180	183
Sand + Gravel	183	222
Chalk	222	245
SAND	245	272

WELL LOCATION:  
sec. 14 T. 2 N. R. 2 E.  
4 miles N of Avondale  
(distance) (direction) (nearest town)

WELL PURPOSE: Home  
(home, irrigation, municipal, industrial)

WELL COMPLETION DATA:

(1) diameter (inches) 4"

(2) total depth (feet) 272

(3) static water level (feet) 160 below top of ground

(4) casing PVC 272  
(material) (depth)  
4"  
(size) if telescope see back.

(5) screen 10' 272  
(length) (depth to top)  
4" PVC  
(size) (material)


(6) pump 1 10  
(HP) (yield gpm)  
elec  
(type power)

(7) electric log no  
(yes or no)  
MGS - shows 700'  
(organization running log)

(8) how well bottom plugged  
B.W. Valve

**CODED**


DRILLERS REMARKS: Well set at 272' not sufficient at 700'

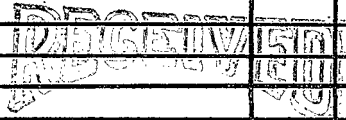

MAR 29 1975

If well telescopes please sketch and show depths.

GROUND LEVEL

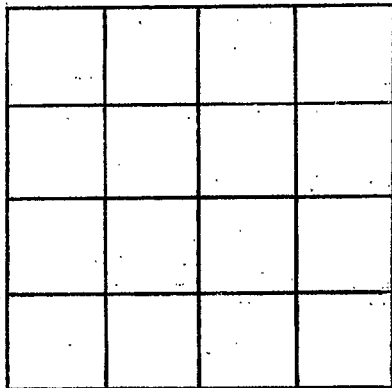

SECTION \_\_\_\_\_

Please indicate well location X.

ADDITIONAL INFORMATION

If more than one screen, show locations of each on sketch.