

SIMPSON
B22
11-2-76
Flg # 181

MISSISSIPPI
BOARD OF WATER COMMISSIONERS
416 North State Street
Jackson, Mississippi 39201

CODED

WATER WELL DRILLERS LOG

11/2/76 19 R. E. Thompson Simpson
date well completed firm name county well located

LANDOWNER:	description of formations encountered	from	to
<u>Charles Lewis</u>			
<u>Hain well miss.</u> (mailing address)			
WELL LOCATION: sec <u>23</u> T <u>2</u> N R <u>2</u> E S W <u>2</u> miles <u>W</u> of <u>Throumville</u> (distance) (direction) (nearest town)			
WELL PURPOSE: (home, irrigation, municipal, industrial)			
WELL COMPLETION DATA:			
(1) diameter (inches) <u>2</u>			
(2) total depth (feet) <u>320</u>			
(3) static water level (feet) <u>73</u> ^{below} _{above} top of ground.			
(4) casing <u>Plastic 306</u> (material) (depth) <u>2"</u> (size) If telescope see back.			
(5) screen <u>14"</u> <u>306</u> (length) (depth to top)			
(6) pump <u>.008</u> <u>Plastic</u> (size) (material)			
(6) pump <u>1 1/2</u> <u>6</u> (HP) (yield gpm)			
(7) electric log <u>yes</u> (yes or no)			
(8) organization running log <u>M. S. S.</u> (organization running log)			
(8) how well bottom plugged <u>Red Wood</u>			
DRILLERS REMARKS:			

CODED


Record loss

RECEIVED
SEP 28 1977

RD. OF WATER COMMISSIONERS

If well telescopes please sketch and show depths.

GROUND LEVEL

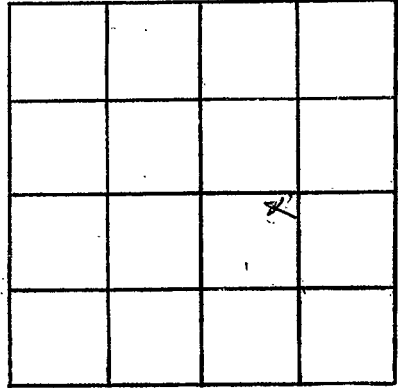

SECTION 3.3

Please indicate well location X.

ADDITIONAL INFORMATION

If more than one screen, show locations of each on sketch.