

SIMPSON
B24
9-16-77
Elog # 189

MISSISSIPPI
BOARD OF WATER COMMISSIONERS
416 North State Street
Jackson, Mississippi 39201

CODED

WATER WELL DRILLERS LOG

9-16-1977 M. Guinn WATER well serv Simpson
date well completed firm name county well located

LANDOWNER: W-D. BIRD

(mailing address)

description of formations encountered	from	to
CLAY	0	20
SAND	20	58
CLAY	50	200
SAND	200	270

WELL LOCATION:
sec. 23 T. 2 N R. 2 E
S W

miles of
(distance) (direction) (nearest town)

WELL PURPOSE:
(home, irrigation, municipal, industrial)

WELL COMPLETION DATA:
 (1) diameter (inches) 4"
 (2) total depth (feet) 270
 (3) static water level (feet) 70 below top of ground.
 (4) casing PVC 260 (material) (depth)
 4" if telescope see back. (size)
 (5) screen 10" 260 (length) (depth to top)
 4" PVC (size) (material)
 (6) pump 1/2 3 (HP) (yield gpm)
 (type power) yes
 (7) electric log yes (yes or no)
 MAS (organization running log)
 (8) how well bottom plugged 130W

CODED


RECEIVED

NOV 16 1977

DRILLERS REMARKS:

If well telescopes please sketch and show depths.

GROUND LEVEL

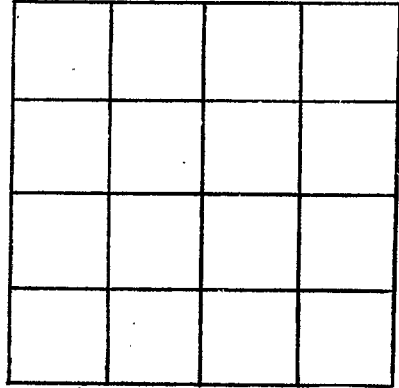

SECTION _____

Please indicate well location X.

ADDITIONAL INFORMATION

If more than one screen,
show locations of each on sketch.