

SIMPSON
B25

4/13/78

E Log # 199

4/13 1978
date well completed

MISSISSIPPI
BOARD OF WATER COMMISSIONERS
416 North State Street
Jackson, Mississippi 39201

CODED

WATER WELL DRILLERS LOG

1978 Guinn Water
Jack D. firm name

Simpson
RD
Simpson
county well located

LANDOWNER:

Jim McIRHEAD

(mailing address)

WELL LOCATION:

sec. 9 T 2 N R 2 E
S W

(distance) miles (direction) of (nearest town)

WELL PURPOSE:
(home, irrigation, municipal, industrial)

CODED

WELL COMPLETION DATA:

- (1) diameter (inches) 4
- (2) total depth (feet) 200
- (3) static water level (feet) UNK below top of ground.
- (4) casing PVC, 200 (material) (depth)
- (size) 4 If telescope see back.
- (5) screen 20, 200 (length) (depth to top)
- (size) 4 (material) PVC
- (6) pump 1, 10 (HP) (yield gpm)
- (type power)
- (7) electric log YES (yes or no)
- MGS (organization running log)
- (8) how well bottom plugged B/W

description of formations encountered

from to

| | | |
|------|-----|-----|
| CLAY | 0 | 158 |
| SAND | 156 | 160 |
| CLAY | 166 | 200 |
| SAND | 200 | 220 |


DRILLERS REMARKS:

RECEIVED
MAY 21 1978

MISS. Bd. OF WATER COMMISSIONERS

If well telescopes please sketch and show depths.

GROUND LEVEL

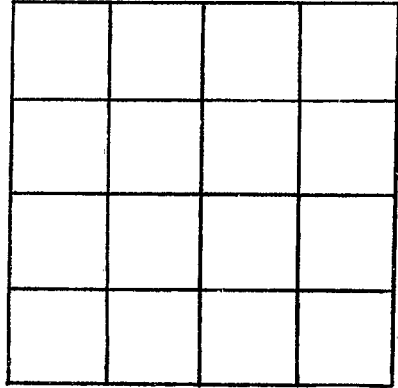

SECTION _____

Please indicate well location X.

ADDITIONAL INFORMATION

A series of horizontal lines for recording additional information, starting below the 'ADDITIONAL INFORMATION' header and extending to the bottom of the page.

If more than one screen, show locations of each on sketch.