

MISSISSIPPI DEPARTMENT OF NATURAL RESOURCES

Bureau of Land and Water Resources

Southport Mall

P.O. Box 10631

Jackson, Mississippi 39209

WATER WELL DRILLERS LOG

CODED

SIMPSON
B26 79
2-1-89
Elog # 227

19 2- 19 Jack D. Quinn Simpson
date well completed firm name county well located

LANDOWNER: Skip Allen

description of formations encountered	from	to
	<u>CLAY</u> <u>Shred</u>	<u>0</u> <u>120</u>

(mailing address)

WELL LOCATION:
sec. 9 T 2 (N) R 2 (E)

(distance) miles (direction) of (nearest town)

CODED

WELL PURPOSE: Home
(home, irrigation, municipal, industrial)

WELL COMPLETION DATA:

- (1) diameter (inches) 4 7/8
- (2) total depth (feet) 160
- (3) static water level (feet) 100 below above top of ground.
- (4) casing PVC 140
(material) (depth)
4 9/8
(size) if telescope see back.
- (5) screen 20 140
(length) (depth to top)
4 PVC
(size) (material)
- (6) pump 1 10
(HP) (yield gpm)
(type power)
- (7) electric log Yes
(yes or no)
MGS
(organization running log)

(8) how well bottom plugged

DRILLERS REMARKS: Well #1


DEPT. OF NATURAL RESOURCES
BUREAU OF LAND & WATER RESOURCES

DEC - 9 1980

RECEIVED

If well telescopes please sketch and show depths.

GROUND LEVEL

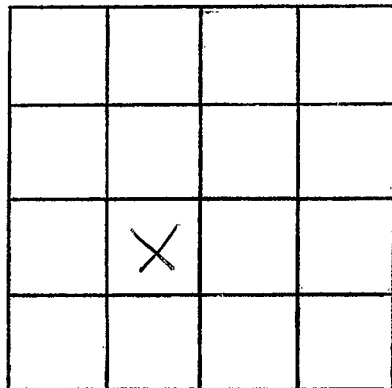

SECTION 9

Please indicate well location X.

ADDITIONAL INFORMATION

If more than one screen, show locations of each on sketch.