

MISSISSIPPI DEPARTMENT OF NATURAL RESOURCES

Bureau of Land and Water Resources

Southport Mall

P.O. Box 10631

Jackson, Mississippi 39209

CODED

WATER WELL DRILLERS LOG

SIMPSON
B30
2-21-80
Elog #242

19 80 date well completed Jack D. Gunn firm name Simpson county well located

LANDOWNER:	description of formations encountered	from	to
<u>Skip Allen</u>			
(mailing address)			
WELL LOCATION:			
sec. <u>9</u> T. <u>20</u> S. R. <u>2</u> E. W.			
miles of (distance) (direction) of (nearest town)			
WELL PURPOSE: <u>Home</u> (home, irrigation, municipal, industrial)			
WELL COMPLETION DATA:			
(1) diameter (inches)			
(2) total depth (feet)			
(3) static water level (feet) _____ below above top of ground.			
(4) casing _____ (material) _____ (depth) _____ _____ (size) if telescope see back.			
(5) screen _____ (length) _____ (depth to top) _____ _____ (size) _____ (material)			
(6) pump _____ (HP) _____ (yield gpm) _____ _____ (type power)			
(7) electric log _____ (yes or no) _____ _____ (organization running log)			
(8) how well bottom plugged _____			
DRILLERS REMARKS: <u>Well #2</u>			

CODED

*Well*


MISSISSIPPI DEPARTMENT OF NATURAL RESOURCES  
BUREAU OF LAND & WATER RESOURCES

DEC 9 1980

RECEIVED

If well telescopes please sketch and show depths.

GROUND LEVEL

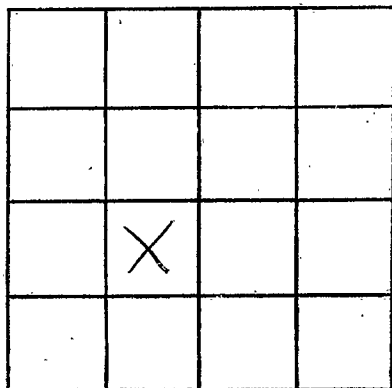

SECTION 9

Please indicate well location X.

ADDITIONAL INFORMATION

If more than one screen,  
show locations of each on sketch.