

SIMPSON
B31
5-15-80

MISSISSIPPI
BOARD OF WATER COMMISSIONERS CODED
416 North State Street
Jackson, Mississippi 39201

WATER WELL DRILLERS LOG

5-15-1980 date well completed
Simpson Well Drilling firm name
Simpson county well located

LANDOWNER:
Albert Paul
(mailing address)

description of formations encountered	from	to
<i>CLAY SAND</i>	<i>0</i>	<i>150</i>
	<i>150</i>	<i>220</i>

WELL LOCATION:
sec. 2 T 2 N R 2 E
S W
miles of (distance) (direction) (nearest town)

CODED		
-------	--	--

WELL PURPOSE:
(home, irrigation, municipal, industrial)

WELL COMPLETION DATA:

(1) diameter (inches) 2"

(2) total depth (feet) 220

(3) static water level (feet) 98 below top of ground.

(4) casing PVC (200 depth), 2 (size) if telescope see back.

(5) screen 20 (200 length), 200 (depth to top), 2 (size), PVC (material)

(6) pump 1 (HP), 4 (yield gpm)

(type power)

(7) electric log yes (yes or no), MBS (organization running log)

(8) how well bottom plugged Back


CODED		
-------	--	--

DRILLERS REMARKS:

DEPT. OF NATURAL RESOURCES
BUREAU OF LAND AND WATER RESOURCES
MAY 28 1980
RECEIVED

If well telescopes please sketch and show depths.

GROUND LEVEL

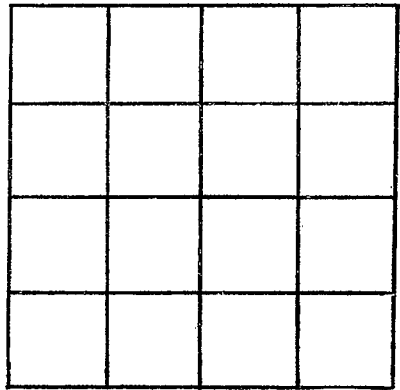

SECTION _____

Please indicate well location X.

ADDITIONAL INFORMATION

If more than one screen, show locations of each on sketch.