

SIMPSON
 B35
 2-24-81
 Elog # 264
 9-24 19

MISSISSIPPI
 BOARD OF WATER COMMISSIONERS
 416 North State Street
 Jackson, Mississippi 39201

CODED

WATER WELL DRILLERS LOG

21 Guinn Well Soc Simpson
 firm name county well located

LANDOWNER:

Dr. Estes Blackburn
 (mailing address)

description of formations encountered

from to

CLAY	0	40
SHAL	40	60
STEADY SAND	60	90
SHAL	90	180
STEADY SAND	70	150

WELL LOCATION:

sec. 5 T 2 N R 2 E
 S W

(distance) miles (direction) of (nearest town)

WELL PURPOSE:

(home, irrigation, municipal, industrial)

WELL COMPLETION DATA:

- (1) diameter (inches) 2"
- (2) total depth (feet) 150
- (3) static water level (feet) 90 below top of ground.
- (4) casing PVC 160 (material) (depth) 2" (size) if telescope see back.
- (5) screen 20" 160 (length) (depth to top) 2" PVC (size) (material)
- (6) pump 1 6 (HP) (yield gpm)


(type power)

(7) electric log (yes or no)

(organization running log)


(8) how well bottom plugged BOW

DRILLERS REMARKS:

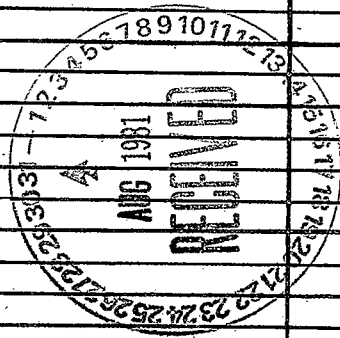

If well telescopes please sketch and show depths.

GROUND LEVEL

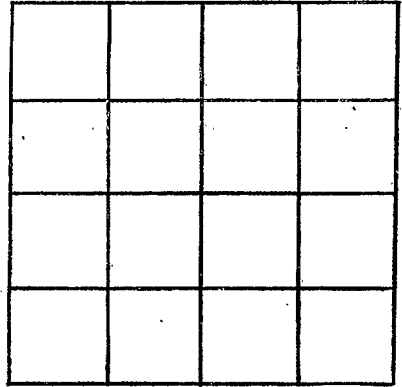

SECTION _____

Please indicate well location X.

ADDITIONAL INFORMATION

If more than one screen, show locations of each on sketch.