

MISSISSIPPI DEPARTMENT OF NATURAL RESOURCES
Bureau of Land and Water Resources

Southport Mall
P.O. Box 10631

Jackson, Mississippi 39209

WATER WELL DRILLERS LOG

CODED

Griner Drilling
Service, Inc.

SIMPSON

Simpson
B 37
3-19-81

3-19-81 date well completed Griner Drilling Service, Inc. firm name SIMPSON county well located

LANDOWNER:

Shell Oil Company
P.O. Box 61555
New Orleans, La.
(mailing address)

description of formations encountered

from to

clay & rock	0	94
pea gravel & sand	94	200
streaked sand & clay	200	240
clay, sand, rock	240	300
clay, rock, sand	300	450
sand & clay	450	552
clay, rocks	552	562

WELL LOCATION:

84015 + 301E

No. 1 R-2 T-20 S R-20 of McBehee Harrisville W. of Nulco
(distance) (direction) (nearest town)

WELL PURPOSE:

oil field supply
(home, irrigation, municipal, industrial)


WELL COMPLETION DATA:

- (1) diameter (inches) 6"
- (2) total depth (feet) 562'
- (3) static water level (feet) 50' below top of ground
- (4) casing steel 48' (material) (depth)
- 6" (size) If telescope see back.
- (5) screen 42' 445' (length) (depth to top)
- 6" stainless steel (size) (material)
- (6) pump 20 300 (HP) (yield gpm)
- 460 Volt (type power)
- (7) electric log NO (yes or no)

(organization running log)

(8) how well bottom plugged 6" backwash valve

DRILLERS REMARKS:

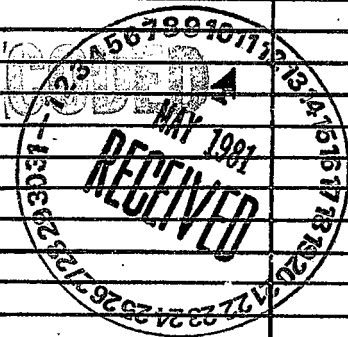


See 280 on 195



If well telescopes please sketch and show depths.

GROUND LEVEL

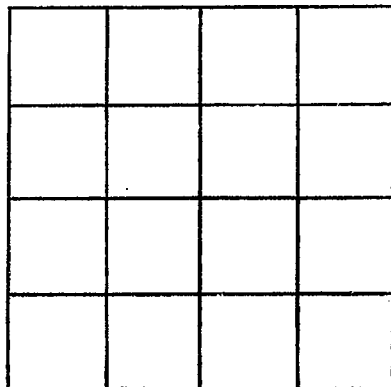

SECTION _____

Please indicate well location X.

ADDITIONAL INFORMATION

If more than one screen,
show locations of each on sketch.