

MISSISSIPPI DEPARTMENT OF NATURAL RESOURCES

Bureau of Land and Water Resources

Southport Mall

P.O. Box 10631

Jackson, Mississippi 39209

WATER WELL DRILLERS LOG

CODED

SIMPSON

B42

7-22-82

7-22-82

Griner Drilling Service, INC.

SIMPSON

date well completed

firm name

county well located

LANDOWNER:

Shell Oil Company
P.O. Box 61555
New Orleans, La. 70160
(mailing address)

description of formations encountered

from

to

Top Soil	0	10
streaked sand	10	40
clay	40	125
sand, shell	125	147
chalk	147	180
sand	180	220
chalk CODED	220	240
sand	240	263
chalk	263	390
streaked sand-shell	390	495
chalk	495	609

WELL LOCATION:

2400N 41700W

sec. 17 T. 20 N R. 20 E of SE 1/4

No. 1
Bd. 101
Elev. 101

Harrisville

WELL PURPOSE: oil field supply

WELL COMPLETION DATA:

- (1) diameter (inches) 6"
- (2) total depth (feet) 609'
- (3) static water level (feet) 65' below top of ground.
- (4) casing Steel 273' (material) (depth)
- (5) screen 6" (size) If telescope see back. 203 - 223 (length) 40' (depth to top) 243 - 263
- (6) pump 6" (size) stainless steel (material)
- (7) pump 20 (HP) 200 (yield gpm)
- (8) electric log yes (yds or no)
- (9) 160 volt 3 phase (type power)
- (10) Bureau of Geology (organization running log)
- (11) back wash valve wood plug (how well bottom plugged)

DEPT. OF NATURAL RESOURCES
BUREAU OF LAND & WATER RESOURCES

AUG - 4 1982


RECEIVED

DRILLERS REMARKS:



If well telescopes please
sketch and show depths.

GROUND LEVEL

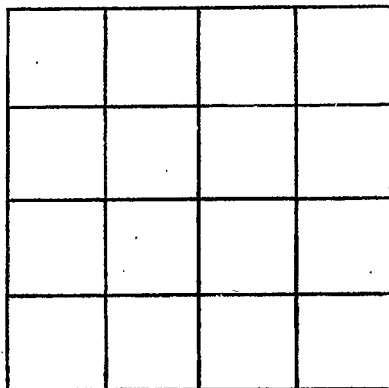

SECTION _____

Please indicate well location X.

ADDITIONAL INFORMATION

If more than one screen,
show locations of each on sketch.