

SIMPSON
B43
3/17/83

MISSISSIPPI DEPARTMENT OF NATURAL RESOURCES
Bureau of Land and Water Resources
Southport Mall
P.O. Box 10631
Jackson, Mississippi 39209
WATER WELL DRILLERS LOG

CODED

Simpson

3/17 1983 Jack Quinn water (Simpson) Stinds
date well completed firm name well loc. county well located

LANDOWNER: Daisy Barlow
Bryanton, Mrs.

description of formations encountered	from	to
Red sand & clay	0	120
Clay & shell	120	280
Sand	280	330

(mailing address)

WELL LOCATION:
sec. 12 T. 2 N. R. 2 E.
3 miles S. of Star
(distance) (direction) (nearest town)

WELL PURPOSE: Home
(home, irrigation, municipal, industrial)

WELL COMPLETION DATA:

- (1) diameter (inches) 4 in.
- (2) total depth (feet) 330 ft.
- (3) static water level (feet) 135 ft. below top of ground.
- (4) casing P.V.C., 290 ft.
(material) (depth)
- 4 in. if telescope see back.
(size)
- (5) screen 30 ft., 290 ft.
(length) (depth to top)
- 4 in., P.V.C.
(size) (material)
- (6) pump 1, 10
(HP) (yield gpm)
Electric
(type power)
- (7) electric log yes
(yes or no)
m. H. S.
(organization running log)
- (8) how well bottom plugged Back
wash valve

CODED

DEPT. OF NATURAL RESOURCES
BUREAU OF LAND & WATER RESOURCES


MAY 8 - 1983

RECEIVED

DRILLERS REMARKS:

If well telescopes please sketch and show depths.

GROUND LEVEL

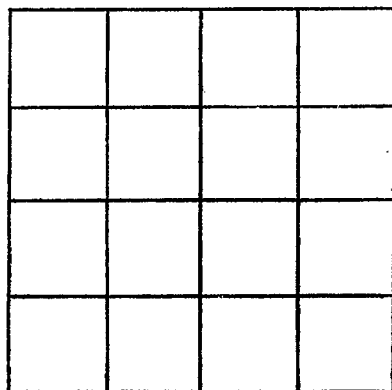

SECTION _____

Please indicate well location X.

ADDITIONAL INFORMATION

If more than one screen, show locations of each on sketch.