

SIMPSON  
 B44  
 8-3-83  
 Flog # 299  
 8-3

MISSISSIPPI  
 BOARD OF WATER COMMISSIONERS  
 416 North State Street  
 Jackson, Mississippi 39201

CODED

WATER WELL DRILLERS LOG

1983 date well completed  
 83 Gainwellson Simpson firm name  
 county well located

LANDOWNER:  
 R. L. STARTER  
 (mailing address)

description of formations encountered	from	to
CLAY SAND	0	220
	205	220

WELL LOCATION:  
 sec. 1 T. 2 N. R. 2 E.  
 S W  
 (distance) miles (direction) of (nearest town)

CODED

WELL PURPOSE:  
 (home, irrigation, municipal, industrial)

WELL COMPLETION DATA:

(1) diameter (inches) 4 1/2

(2) total depth (feet) 220

(3) static water level (feet) 80 below top of ground.

(4) casing PVC 220  
 (material) (depth)

4 1/2 If telescope see back.  
 (size)

(5) screen 20 200  
 (length) (depth to top)

4 PVC  
 (size) (material)

(6) pump 1 20  
 (HP) (yield gpm)

(type power)

(7) electric log yes  
 (yes or no)

(organization running log)


(8) how well bottom plugged BAW

DRILLERS REMARKS:  
 L

DEPT. OF NATURAL RESOURCES  
 BUREAU OF LAND & WATER RESOURCES  
 NOV 7 1983  
 RECEIVED

If well telescopes please  
sketch and show depths.

GROUND LEVEL

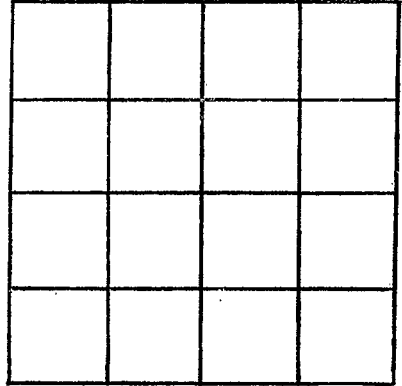

SECTION \_\_\_\_\_

Please indicate well location X.

ADDITIONAL INFORMATION

If more than one screen,  
show locations of each on sketch.