

B46 Elog 305
 Simpson
 7-19-84

MISSISSIPPI
 BOARD OF WATER COMMISSIONERS
 416 North State Street
 Jackson, Mississippi 39201

CODE

WATER WELL DRILLERS LOG


~~100~~
 SIMPSON

7-19 1984 date well completed
 Gann well ser firm name
 SIMPSON county well located

LANDOWNER:	description of formations encountered	from	to
HARLOD BARLOW	SAND	0	50
(mailing address)	CLAY	50	260
WELL LOCATION: sec. 36 T 2 N R 2 E S W	SAND	260	280
(distance) miles (direction) of (nearest town)			
WELL PURPOSE: (home, irrigation, municipal, industrial)			
WELL COMPLETION DATA:			
(1) diameter (inches) 2"			
(2) total depth (feet) 230			
(3) static water level (feet) 60 below top of ground.			
(4) casing PVC 260 (material) (depth) 2" (size) If telescope see back.			
(5) screen 20ft 260 (length) (depth to top) 2" (size) PVC (material)			
(6) pump 1 5 (HP) (yield gpm)			
(type power)			
(7) electric log MFS (yes or no)			
(organization running log)			
(8) how well bottom plugged BCU			1-7-85 LH
DRILLERS REMARKS:			

If well telescopes please sketch and show depths.

GROUND LEVEL

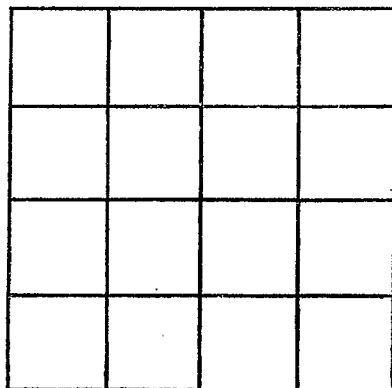

SECTION _____

Please indicate well location X.

ADDITIONAL INFORMATION

If more than one screen,
show locations of each on sketch.