

HERNDON WELL & SUPPLY, INC.

Well Drilling - Pump Sales & Service

P. O. BOX 6917, PEABODY, MISSISSIPPI 39208

PHONE 601/932-4511

LBSS
GW15468

PROJECT Harrisville Water Association DRILLER Jeff Larchee
 LOCATION Mulligan Road DATE COMPLETED _____
 ENGINEER Fuche' & Associates

WELL DATA

Well Depth 208 ft.

187' CASING..... Size 10 in. Material Steel .375 Wall
 Length 187 ft. Coating Yes

CEMENT..... Grout type Type I No. of Sacks 100

149' LAP PIPE..... Size 8 in. Material Steel Coated
 Length 42.52 ft. Type of Seal Gravel

192' SCREEN..... Size 8 in. Brand Johnson
208' T.D. Length 16.3 ft. Material T304SS Slot size Top 3 = 0.010"
 Backwash Valve No Material bottom 3 = 0.015"

GRAVEL PACK... Cubic Yards 1 Size of Underreamed hole 9 7/8 inches

HYDRAULICS.... Static Water Level 82 ft. Pumping Water Level 100.7 ft.
 Drawdown 18.7 ft. Specific Capacity 10.7 gallons/ft.
 Total Dynamic Head 330 ft. Capacity 200 GPM

CHLORINATOR... Hydro Series 500 - Cylinder Mounted - Gas

PUMP DATA

DISCHARGE HEAD..... Oil Lube Water Lube
 Solenoid 120 volts Discharge 6 in.

COLUMN..... Size 5 in. Material Steel Coating Yes
 Length 125' ft. Oil-Tube _____ in. Shafting 1 in.



BOWL ASSEMBLY. Make J-Line Serial No. 27553 Stages 13
 Diameter 8 in. Material Cast Iron
 Suction size 6 in. Length 10 ft.
 Air Line Length 125 ft. Material Copper

ELECTRIC MOTOR DATA

MOTOR..... Vertical Hollow Shaft 25 HP 1760 RPM 3 Phase
 Model/Make US WP-1 : 230 Volts 60 Cycles
 Base Diameter 12 in. Katchet self releasing non reverse
 Other _____

CONTROL PANEL DATA

STARTER..... Size & Make MC Corporation HEATER..... Size & Make _____
 Breaker KAL36150 Fuse C/B
120 Volts 1 Phase Delta Service open closed

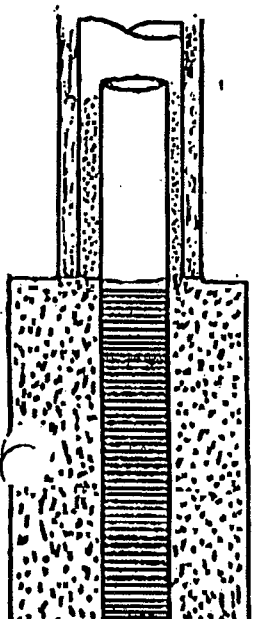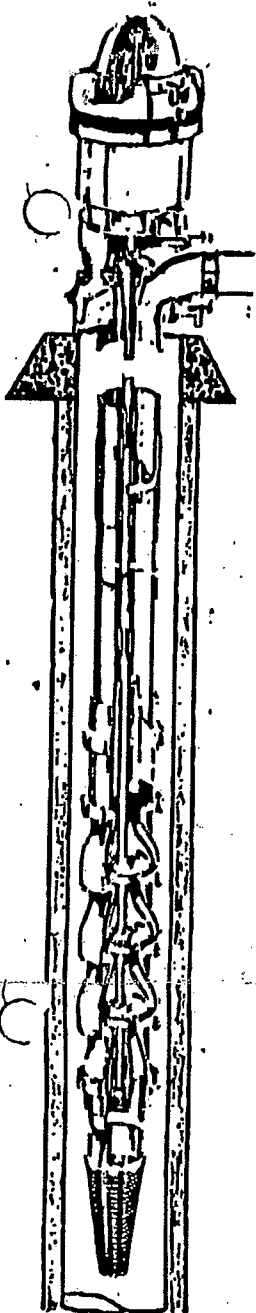

100

100