

MISSISSIPPI DEPARTMENT OF NATURAL RESOURCES

Bureau of Land and Water Resources

Southport Mall

P.O. Box 10631

Jackson, Mississippi 39209

WATER WELL DRILLERS LOG

Simpson
B2000

Sept-8 1981 R. Lee Miller, Simpson
 date well completed firm name county well located

LANDOWNER:	description of formations encountered	from	to
<u>Curtis Leach</u>			
<u>Centennial oak St. Rt. Braxton</u> <small>(mailing address)</small>	<u>Plas</u>	<u>0</u>	<u>18</u>
<u>WELL LOCATION:</u>	<u>hard blue clay</u>	<u>18</u>	<u>55</u>
sec. <u>13</u> T <u>2</u> N R <u>2</u> E	<u>Chalk</u>	<u>35</u>	<u>90</u>
<u>4 1/2</u> miles <u>WSW</u> of <u>Braxton</u>	<u>Chalk & sand</u>	<u>90</u>	<u>242</u>
(distance) (direction) (nearest town)	<u>lime stone</u>		
<u>WELL PURPOSE:</u> <u>house</u>	<u>Coarse sand</u>	<u>240</u>	<u>276</u>
(home, irrigation, municipal, industrial)			
<u>WELL COMPLETION DATA:</u>			
(1) diameter (inches) <u>4"</u>			
(2) total depth (feet) <u>276</u>			
(3) static water level (feet) <u>120</u> below top of ground.			
(4) casing <u>plastic bottom</u> (material) (depth)			
<u>7</u> if telescope see back. (size)			
(5) screen <u>10</u> <u>266</u> (length) (depth to top)			
<u>4"</u> <u>plastic</u> (size) (material)			
(6) pump <u>1 Barb</u> <u>15</u> (HP) (yield gpm)			
<u>elect</u> (type power)			
(7) electric log <u>no</u> (yes or no)			
<u>no</u> (organization running log)			
(8) how well bottom plugged <u>back wash</u>			
<u>DRILLERS REMARKS:</u>			


SEPT. OF NATURAL RESOURCES
 BUREAU OF LAND & WATER RESOURCES

JUN 15 1982

RECEIVED

If well telescopes please sketch and show depths.

GROUND LEVEL

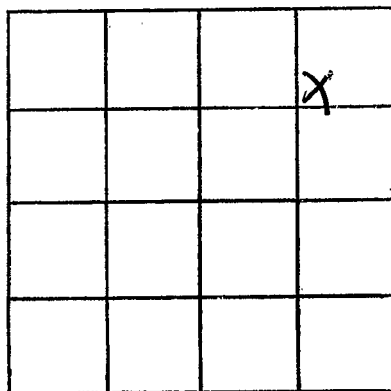

SECTION 13

Please indicate well location X.

ADDITIONAL INFORMATION

If more than one screen,
show locations of each on sketch.