

MISSISSIPPI DEPARTMENT OF NATURAL RESOURCES

Bureau of Land and Water Resources

Southport Mall

P.O. Box 10631

Jackson, Mississippi 39209

WATER WELL DRILLERS LOG

Simpson
B 2000

Sept 25 1982 Russell Will Sr Simpson
 date well completed firm name county well located

LANDOWNER:	description of formations encountered	from	to
<u>John Kuyar</u> <u>Centennial Oak Dr Rt</u> <u>Beauregard</u> (mailing address)			
<u>WELL LOCATION:</u> sec. <u>12</u> T. <u>2</u> N R. <u>2</u> E <u>4 1/2</u> miles <u>WSW</u> of <u>Beauregard</u> (distance) (direction) (nearest town)	<u>hard blue clay</u>	<u>27</u>	<u>60</u>
<u>WELL PURPOSE:</u> <u>Home</u> (home, irrigation, municipal, industrial)	<u>blue chalk</u>	<u>60</u>	<u>86</u>
<u>WELL COMPLETION DATA:</u>	<u>hard blue clay</u>	<u>86</u>	<u>198</u>
(1) diameter (inches) <u>4"</u>	<u>fine sand</u>	<u>198</u>	<u>210</u>
(2) total depth (feet) <u>237</u>	<u>Coarse sand</u>	<u>210</u>	<u>237</u>
(3) static water level (feet) <u>120</u> below top of ground.			
(4) casing <u>plastic bottom</u> (material) (depth)			
(5) screen <u>10</u> <u>227</u> (length) (depth to top)			
(6) pump <u>1 1/2</u> <u>19</u> (HP) (yield gpm)			
(7) electric log <u>no</u> (yes or no)			
(8) how well bottom plugged <u>wash wash</u>			
DRILLERS REMARKS:			


DEPT. OF NATURAL RESOURCES
 BUREAU OF LAND & WATER RESOURCES

JUN 15 1982

RECEIVED

If well telescopes please sketch and show depths.

GROUND LEVEL

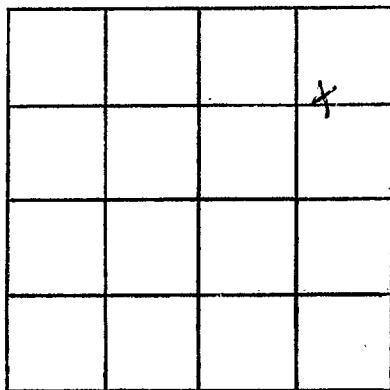

SECTION 13

Please indicate well location X.

ADDITIONAL INFORMATION

If more than one screen,
show locations of each on sketch.