

SIMPSON MISSISSIPPI BOARD OF WATER COMMISSIONERS

El by 52

C1 Elec Log Miss Geological Survey  
6-7-65 WATER WELL DRILLERS LOG

Date: 6-7-65, Driller: James McNeas County Hinds

(Name)


(1) Owner of Land: H. J. DAVIS  
(Name)  
Star Route Brexton Miss  
(Address)  
(2) Location: SW 1/4, SW 1/4, Sec 16 2<sup>N</sup> 3<sup>E</sup>  
3 miles West of Brexton  
(distance) (direction) (Nearest Town)  
(3) Topography: ✓  
(Hilly) (Flat) (Level)  
(4) Purpose of Well: Domestic  
(Domestic Irrigation  
Municipal, Industrial, Other)

Description & Color of Materials Sand, Clay, Red Clay, Shell, etc.	Thick- ness Feet	Depth Feet
Surface soil	10	10
SEND	20	30
CLAY	40	70
SEND	28	98
ROCK	1	99
Blue shale	81	180
SEND	8	188
Grey shale	31	219
SEND	6	225
Grey shale	104	329
ROCK	5	334
Grey shale	15	349
SEND	40	389
Grey shale	9	398
ROCK	3	401
Grey shale	10	411
19 Its 2"	371	
1-2" .007 559	10	
	381	
1-2" Tail pipe BPL	12	
	393	

Information upon completion of well:

(1) Diameter 2" inches.  
(2) Total Depth 411 feet.  
(3) Water Level 225 feet below top of ground.  
(4) Cased to 371', Size 2"  
(5) Screen: Size 2" 007, Length 10  
(6) Were any formations sealed against pollution?  
✓ yes, no.

If YES depth of formation \_\_\_\_\_  
Why \_\_\_\_\_  
Drillers Remarks: \_\_\_\_\_

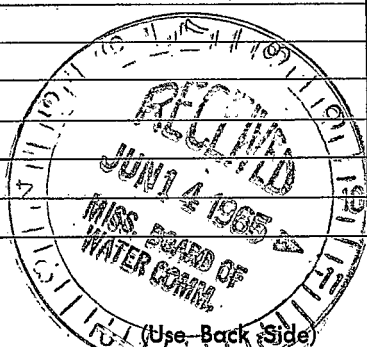

Well No.

