

Simpson  
C 2  
10-66  
Elec Log  
10-18

MISSISSIPPI  
BOARD OF WATER COMMISSIONERS  
416 North State Street  
Jackson, Mississippi 39201

CODED

WATER WELL DRILLERS LOG

19 66 Robert E Ratliff Co Simpson  
date well completed firm name county well located

LANDOWNER: Town of  
Braxton  
Braxton, Miss  
(mailing address)  
WELL LOCATION:  
sec 10 T 20 N R 3 E  
S W  
miles 1.7 of Braxton  
(distance) (direction) (nearest town)

description of formations encountered	from	to
Dirt & Sand	0	20
Shale & Gumbo	20	150
Fine Sand	150	290
Shale & Gumbo	290	445
Rock	445	448
Shale & Vicksburg lime	448	750
Shale	750	1060
Fine Sand	1060	1150

WELL PURPOSE: Municipal  
(home, irrigation, municipal, industrial)


WELL COMPLETION DATA:  
(1) diameter (inches) 8 x 4  
(2) total depth (feet) 1150  
(3) static water level (feet) 155 below above top of ground.  
(4) casing steel, 1060,  
(material) (depth)  
8 x 4  
(size) if telescope see back.  
(5) screen 40', 1071  
(length) (depth to top)  
4", 55  
(size) (material)  
(6) pump 15 150  
(HP) (yield gpm)  
Elec  
(type power)  
(7) electric log yes  
(yes or no)  
MGS  
(organization running log)  
(8) how well bottom plugged BPV

CODED

DRILLERS REMARKS:

(A)

If well telescopes please sketch and show depths.

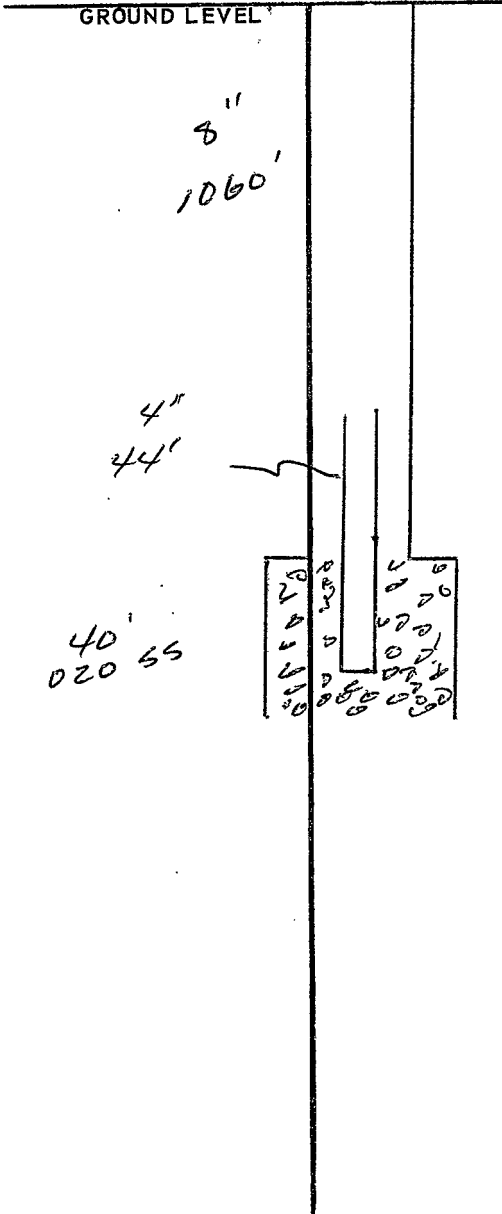

	X		

SECTION 10

Please indicate well location X.

ADDITIONAL INFORMATION

Gravel Pack 1060  
to 1111

drawdown 20'

If more than one screen, show locations of each on sketch.