

Simpson
C 3
5/67
Elec Log
5-19-67

MISSISSIPPI
BOARD OF WATER COMMISSIONERS
416 North State Street
Jackson, Mississippi 39201

CODED

WATER WELL DRILLERS LOG

19 James D McNeas Simpson
date well completed firm name county well located

LANDOWNER:
Jimmie Johnston
Braxton Miss
(mailing address)

WELL LOCATION:
sec. 12 T. 2 N R. 3 E
4 miles west of Braxton
(distance) (direction) (nearest town)

description of formations encountered	from	to
Surface soil	0	3
SDND	3	30
Grey shale	30	100
Blue shale	100	217
ROCK	217	221
SDND	221	237
Grey shale	237	255
ROCK	255	264
Grey shale	264	290
SDND	290	292
Grey sdy sh	292	299
SDND	299	324
Shale	324	369

WELL PURPOSE: HOME
(home, irrigation, municipal, industrial)

WELL COMPLETION DATA:

(1) diameter (inches) 4" x 2"

(2) total depth (feet) 369'

(3) static water level (feet) 180 below top of ground.

(4) casing steel (material), (depth) 4" x 2" (size) if telescope see back.


(5) screen 10' (length), 3/8 (depth to top) 2" stainless steel (size) (material)

(6) pump 1 (HP), 12 (yield gpm) Elec (type power)

(7) electric log yes (yes or no) M.G.S. (organization running log)

(8) how well bottom plugged mud

CODED

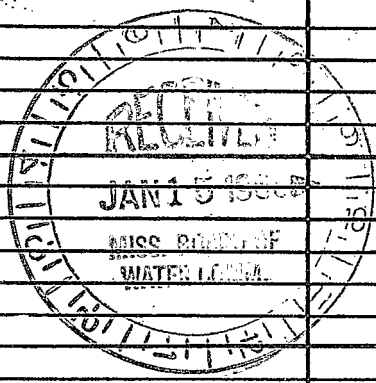

DRILLERS REMARKS:
Water clear

If well telescopes please sketch and show depths.

GROUND LEVEL

4" PIPE

716

4"x7" SWEDEE

1
318

SCREEN

10

328

2" PIPE

7
335

X			

SECTION _____

Please indicate well location X.

ADDITIONAL INFORMATION

If more than one screen, show locations of each on sketch.