

Ellog # 71

Simpson  
CA  
4/67  
Elcc log

MISSISSIPPI  
BOARD OF WATER COMMISSIONERS  
416 North State Street  
Jackson, Mississippi 39201

CODED

WATER WELL DRILLERS LOG

4-7-67 19 James D McNeas SIMPSON  
date well completed firm name county well located


LANDOWNER: D.W. Sheppard  
Star Miss  
  
(mailing address)  
WELL LOCATION:  
sec. 2 T 2 N R 3 E  
S W  
1/2 miles West of Star  
(distance) (direction) (nearest town)

description of fomations encountered	from	to
CLAY	0	10
SAND ROCK	10	15
Blue shale	15	75
Rock	75	80
Rock sh strcs	80	110
SAND	110	115
Shale sd strcs	115	123
SAND	123	165
Grey sh sd strcs	165	189
Grey shale	189	205
Grey sh	205	212
Grey sh	212	259
SAND	259	268
Grey sh	268	277

WELL PURPOSE:  
(home, irrigation, municipal, industrial)

WELL COMPLETION DATA:  
(1) diameter (inches) 4x2"  
(2) total depth (feet) 277  
(3) static water level (feet) 50 below top of ground.  
(4) casing steel (material) (depth) 4x2" (size) if telescope see back.  
(5) screen 10'6" 255 (length) (depth to top) 2" stainless steel (size) (material)  
(6) pump 1 10 (HP) (yield gpm)  
Elcc (type power)  
(7) electric log yes (yes or no)  
M.G.S. (organization running log)  
(8) how well bottom plugged mdd

CODED

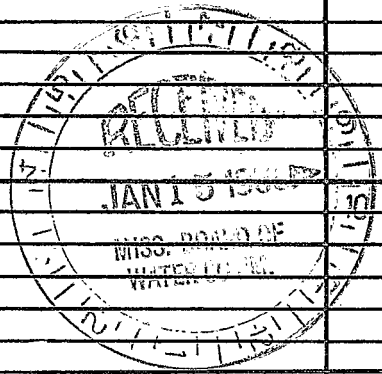

DRILLERS REMARKS:  
Water clear

